


T. 4 S. R. 1 W. W. M.

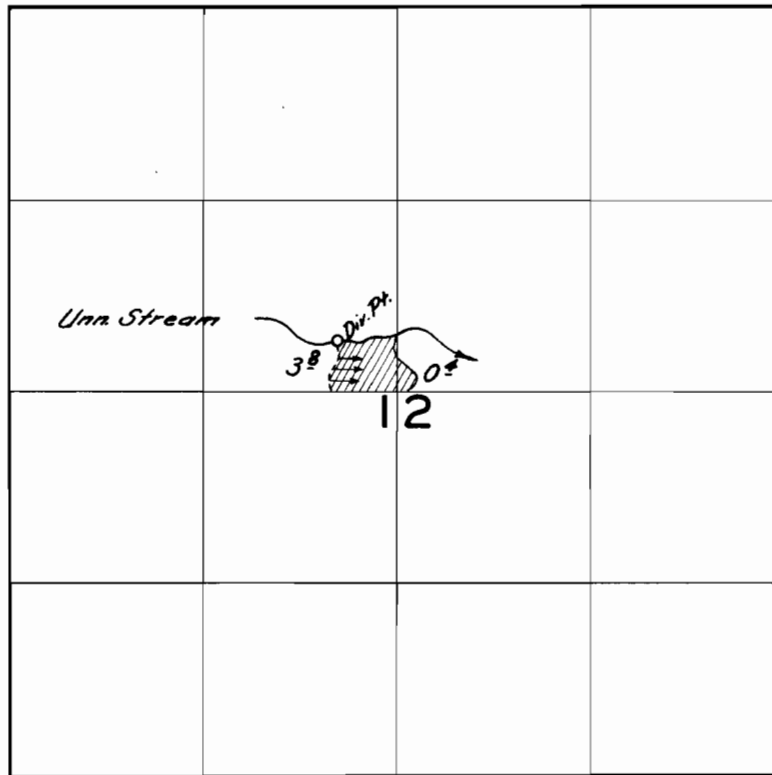

FINAL PROOF SURVEY

UNDER

Application No. 26092 . Permit No. 20400...

IN NAME OF

..... *A. E. Haworth*

Surveyed *June 20, 1956* by *C. O. Bartels*.