


T. 4 S. R. 1 W. W. M.

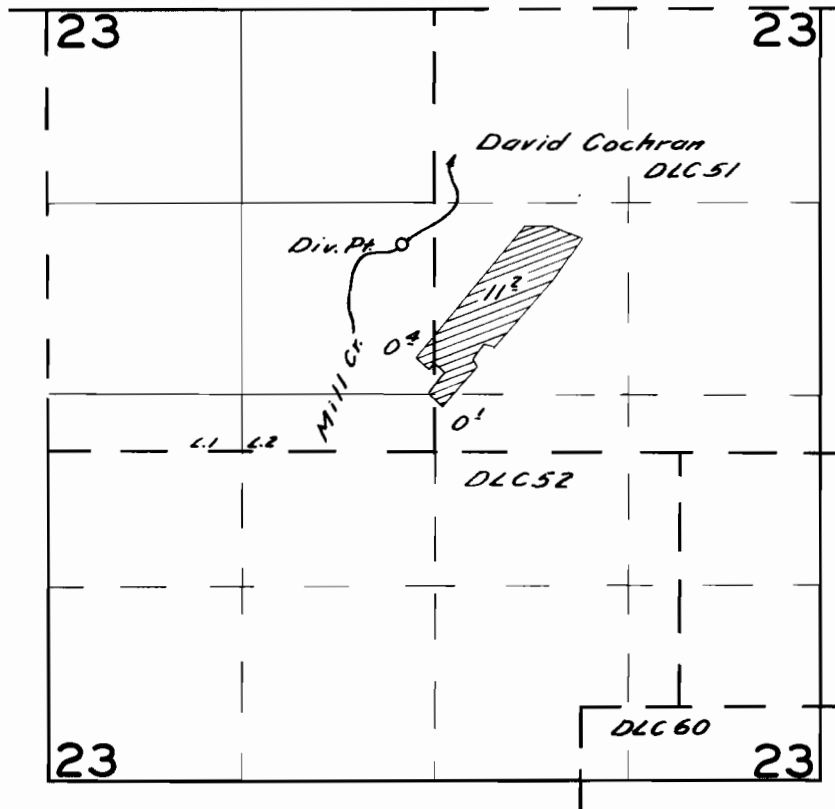

FINAL PROOF SURVEY

UNDER

Application No. 26179... Permit No. 20430..

IN NAME OF

.....*Julius Sather*.....

Surveyed *June 22* 1956, by *C.O. Bartels*.