


T. 3S. R. 1E. W.M.

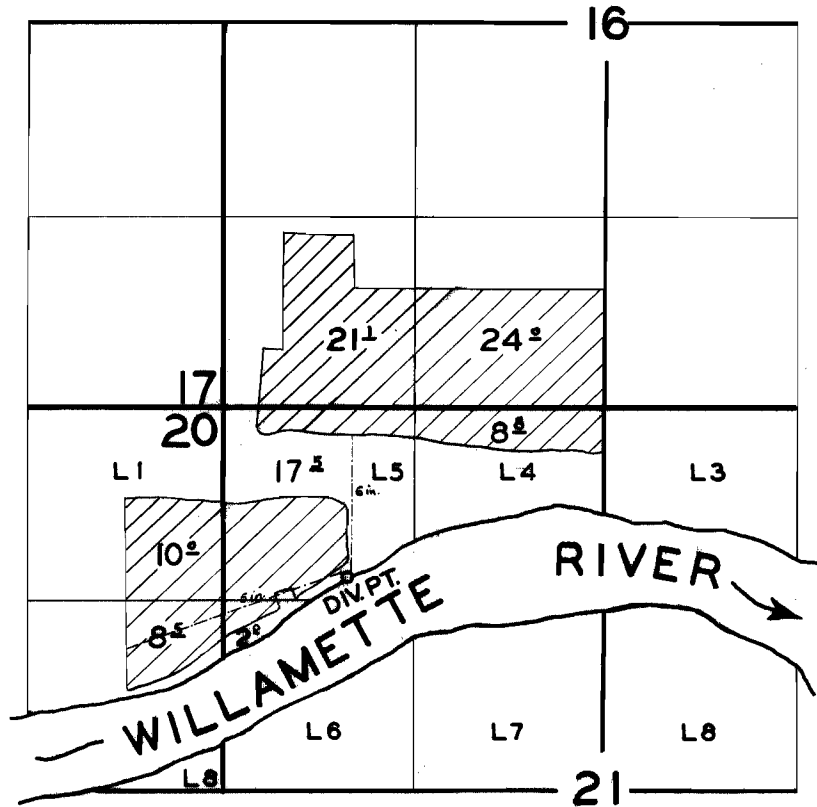

FINAL PROOF SURVEY
UNDER

Application No. 25634 Permit No. 20515
IN NAME OF

OLAF PEDERSON

Surveyed 16 MAY 1956, by R.D. BEST