


T. 6 N. 6 W. W. M.

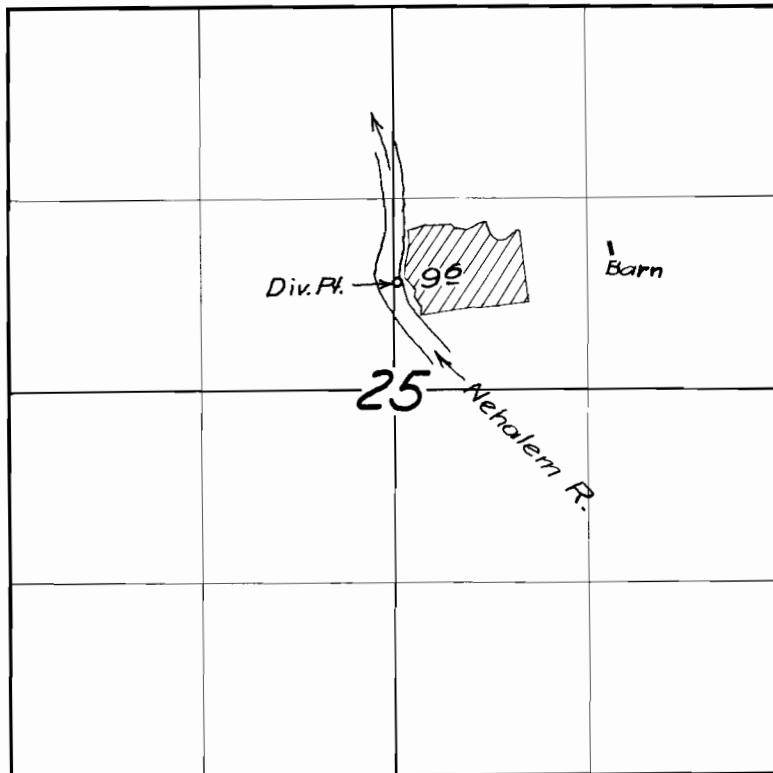

FINAL PROOF SURVEY
UNDER

Application No. 26284 Permit No. 20630
IN NAME OF

Oliver W. Jones

Surveyed 17 Aug. 1956, by Tom Bish