


T. 4 S. R. 1 W. W. M.

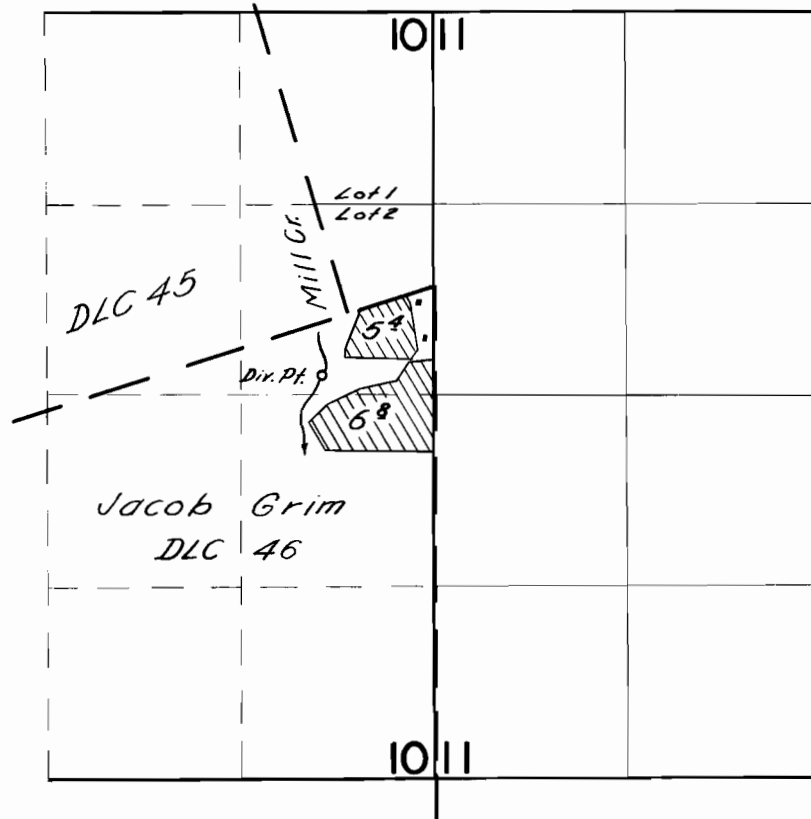

FINAL PROOF SURVEY

UNDER

Application No. 26303. Permit No. 20646.

IN NAME OF

Benjamin R. Jeskey

Surveyed June 20, 1956, by *C.O. Bartels*.