


T.22S. R.8W.W.M.

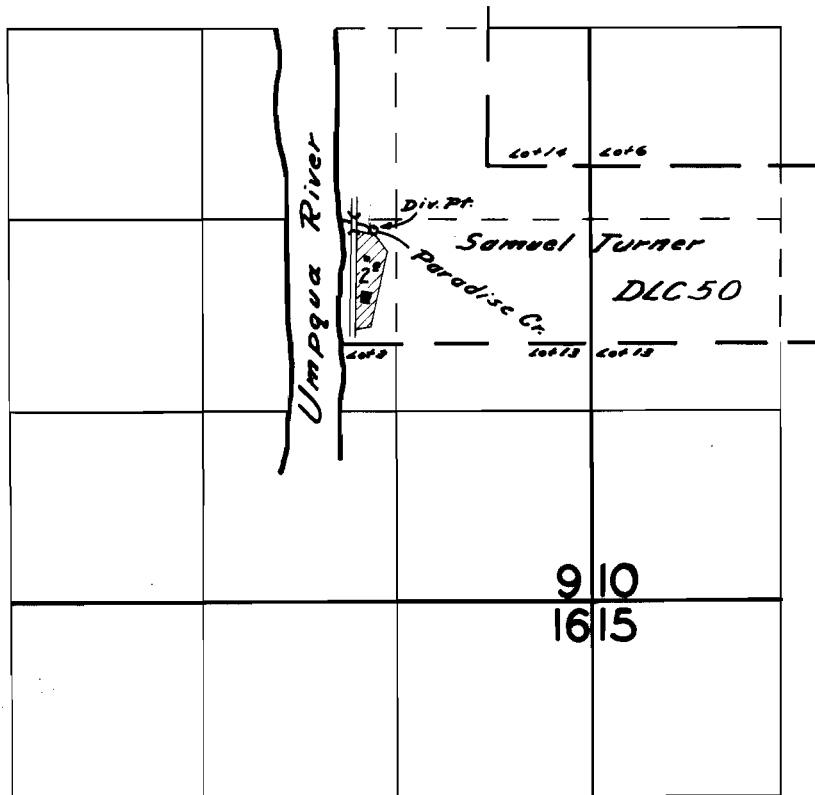

FINAL PROOF SURVEY

UNDER

Application No. *26345*. Permit No. *20670*
IN NAME OF

Walter D. Palmer

Surveyed *July 12*, 1956, by *C.O. Bartels*