


T.23S. R. 4W.W.M.

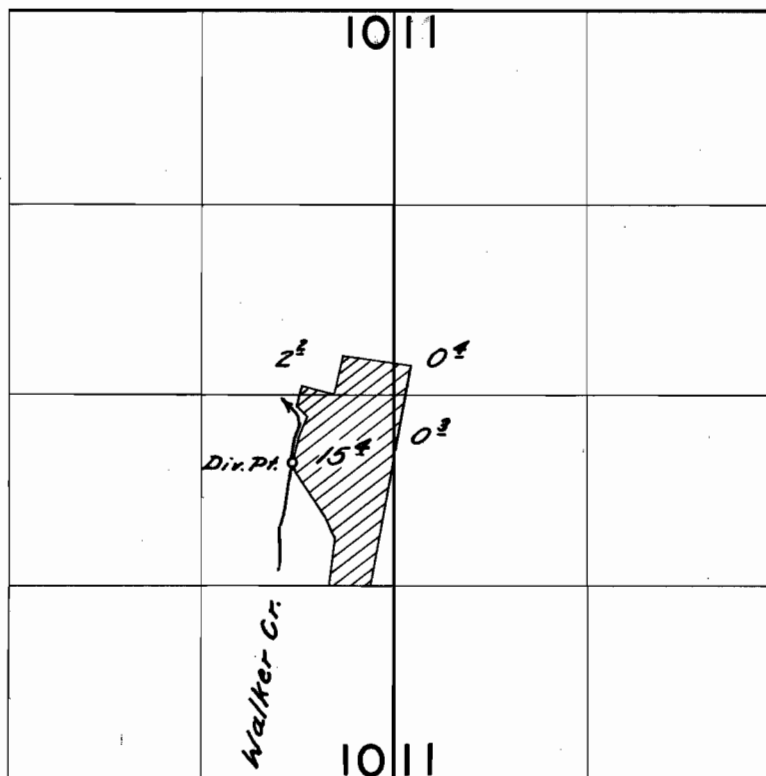

FINAL PROOF SURVEY
UNDER

Application No. 26401... Permit No. 20711...
IN NAME OF

.....*Wilbur J. Briner*.....

Surveyed *July 19* 1956, by *C.O. Bartle*