


T.S.S. R.I.W.

DFN-ILL-42

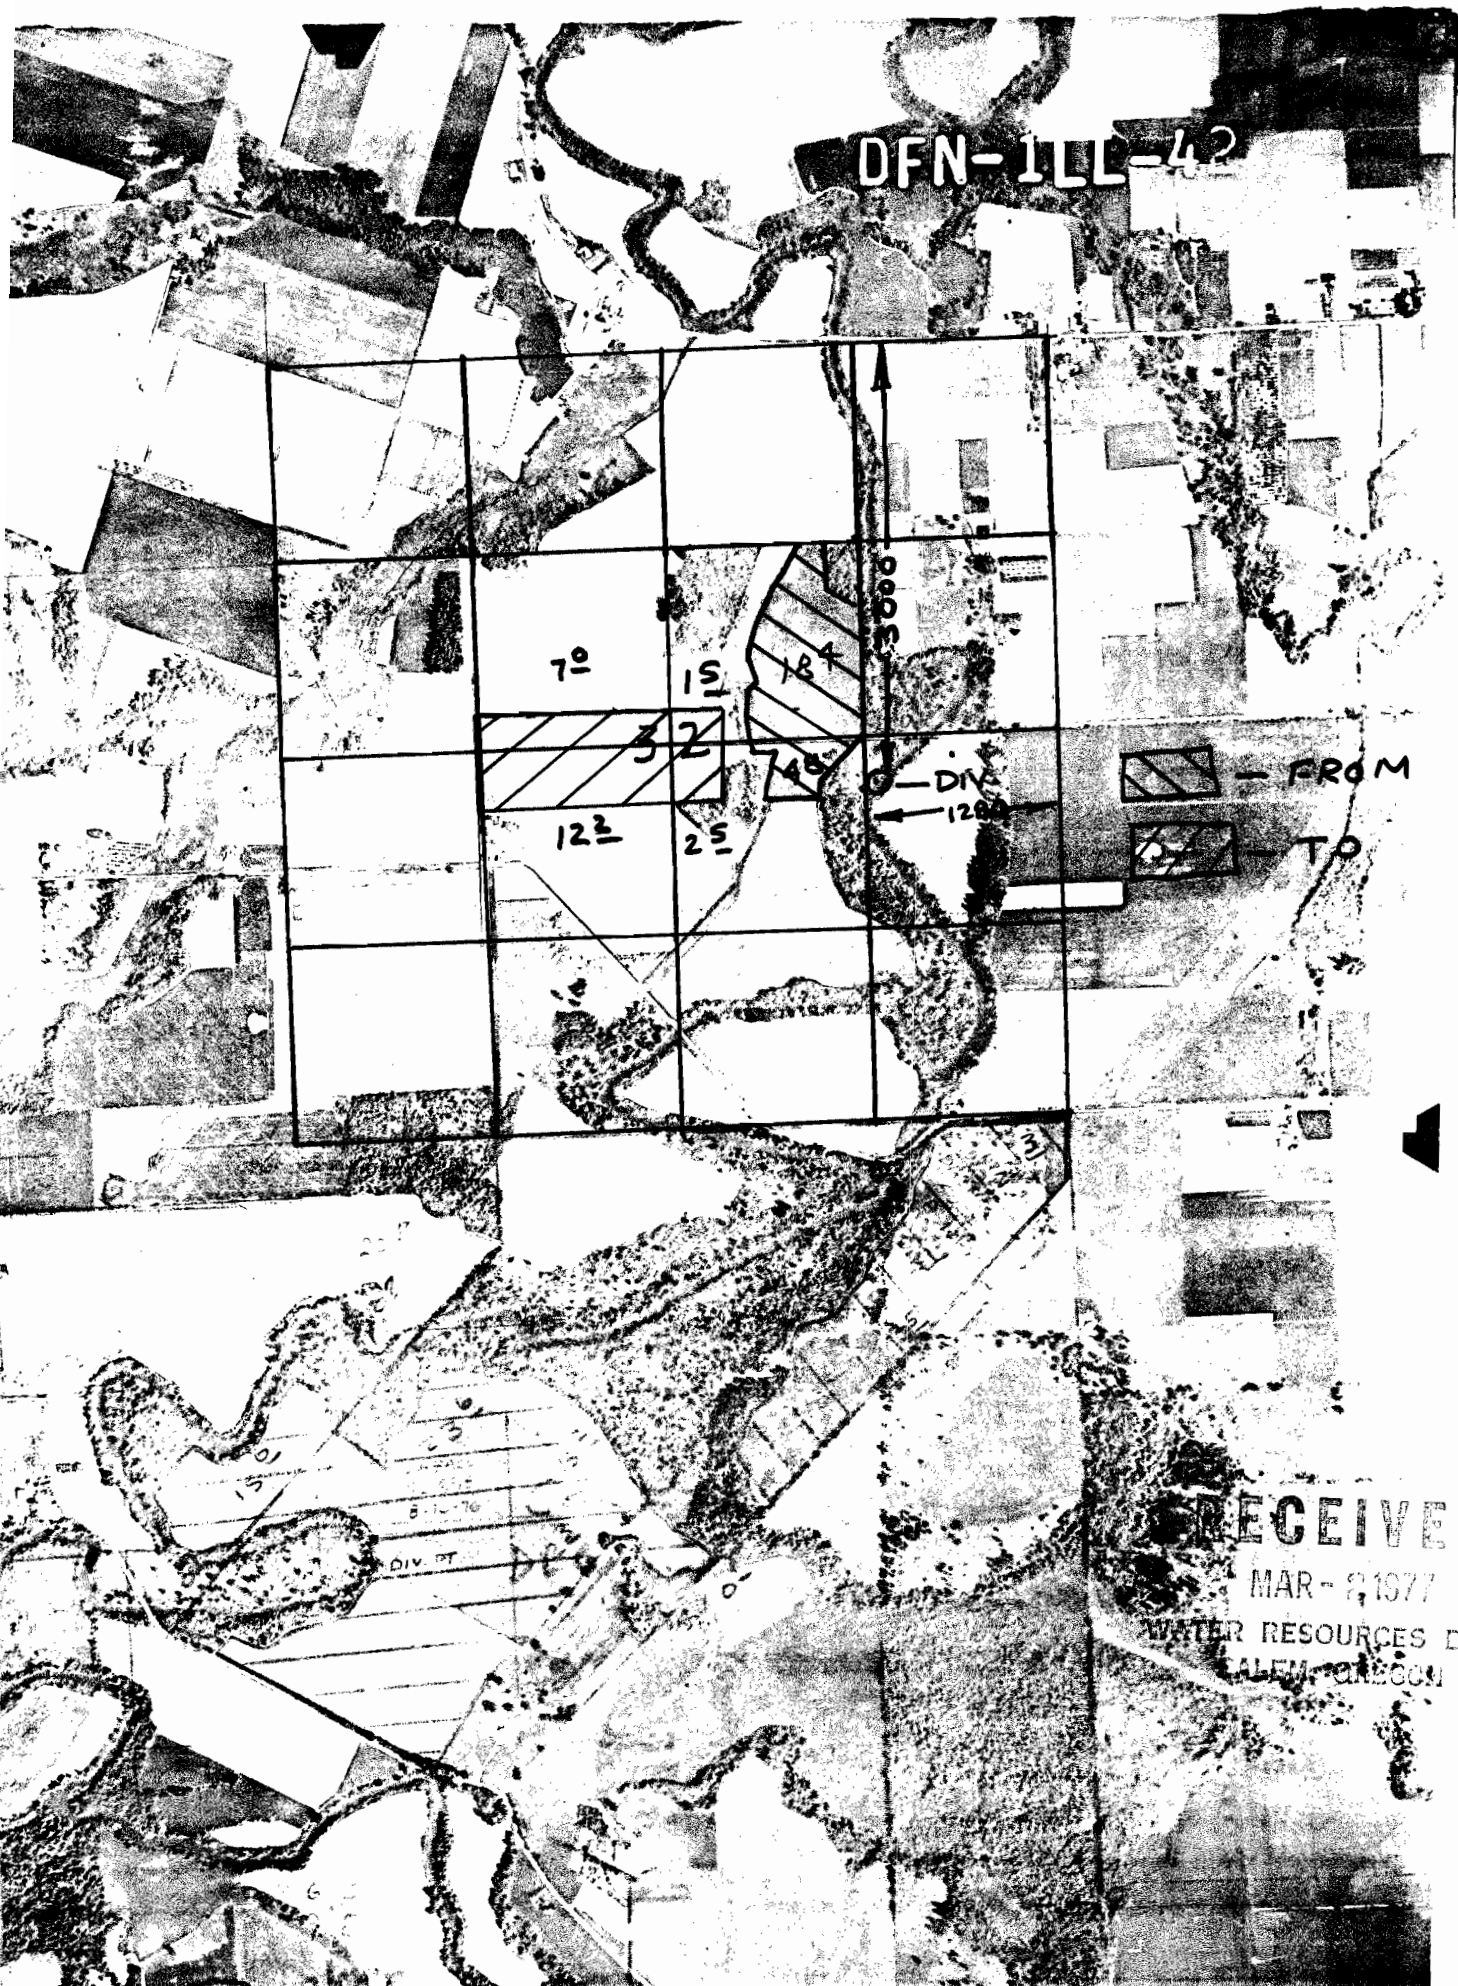

RECEIVED

MAR - 2 1977

WATER RESOURCES DEPT  
