


T.4 S. R.4 W. W.M.

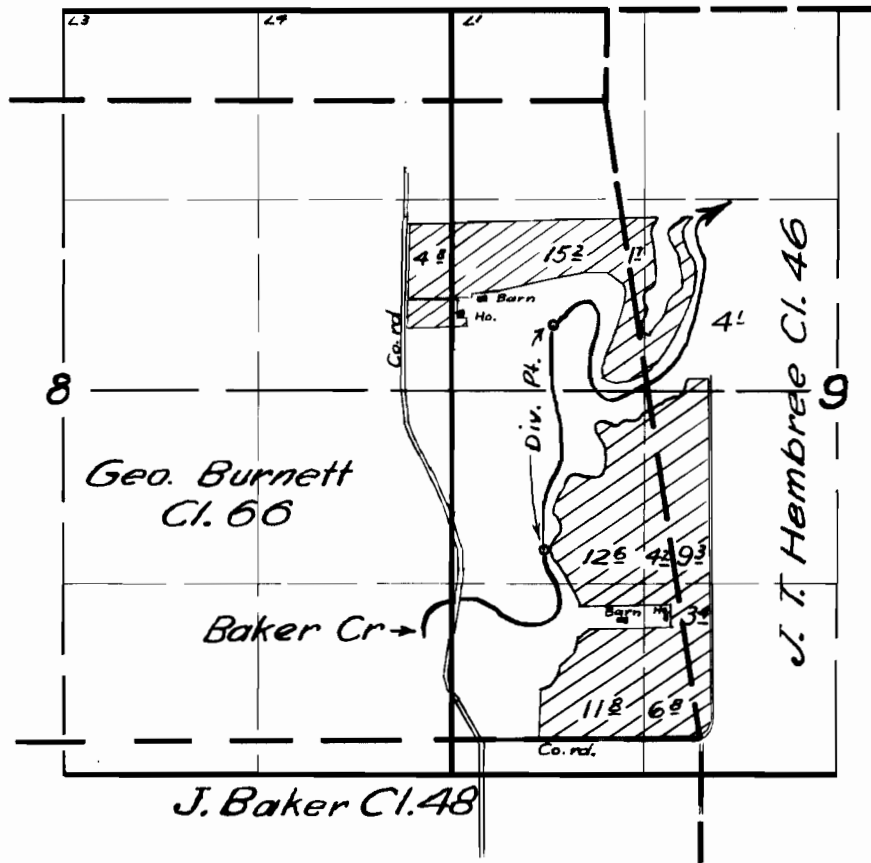

FINAL PROOF SURVEY

UNDER

Application No. 26509. Permit No. 20777

IN NAME OF

O. C. Yocom

Surveyed Mar. 14, 1956, by T. B. Bish