


T.29S. R.8W.W.M.

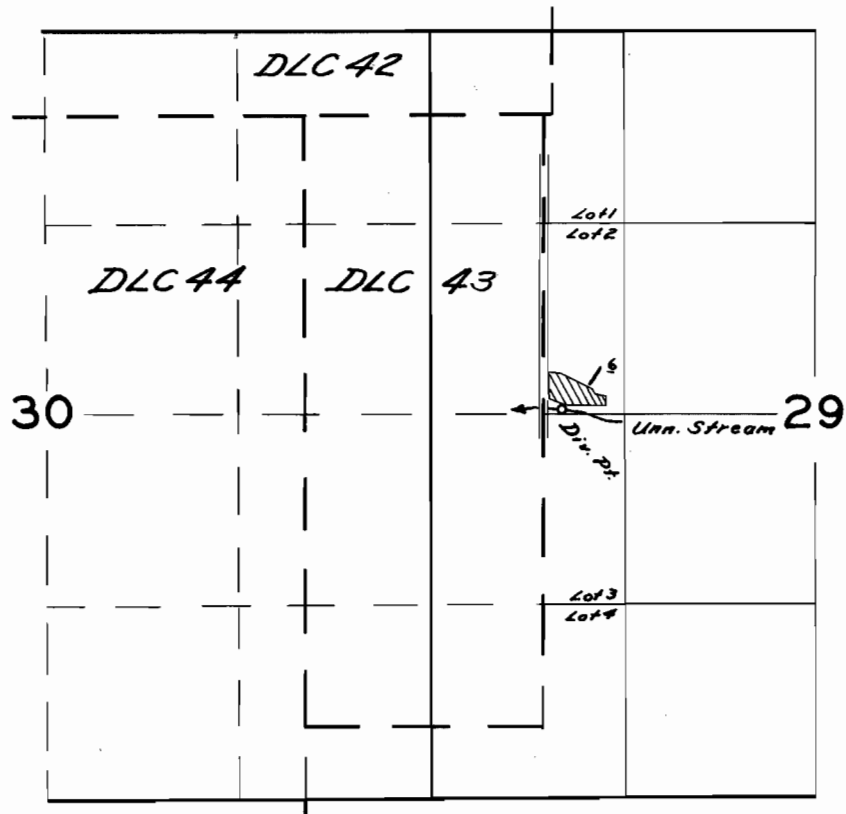

FINAL PROOF SURVEY

UNDER

Application No. 26581 Permit No. 20825

IN NAME OF

Story Martindale

Surveyed Aug. 8 1956, by C.O. Bartels