


T. 4S. R. 1E. W.M.

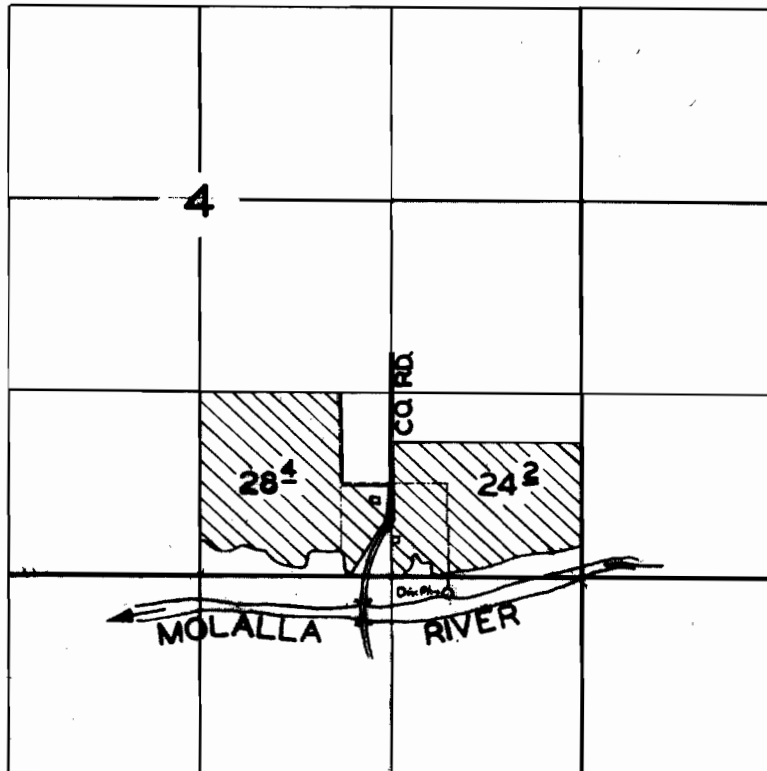

**FINAL PROOF SURVEY**  
UNDER

Application No. **26773** Permit No. **20937**  
IN NAME OF

**OWEN DALEN & ALFRED CHRISTENSON**

Surveyed **23 MAR 1956**, by **R. D. BEST**