


T. 5 S. R. 1 W. W. M.

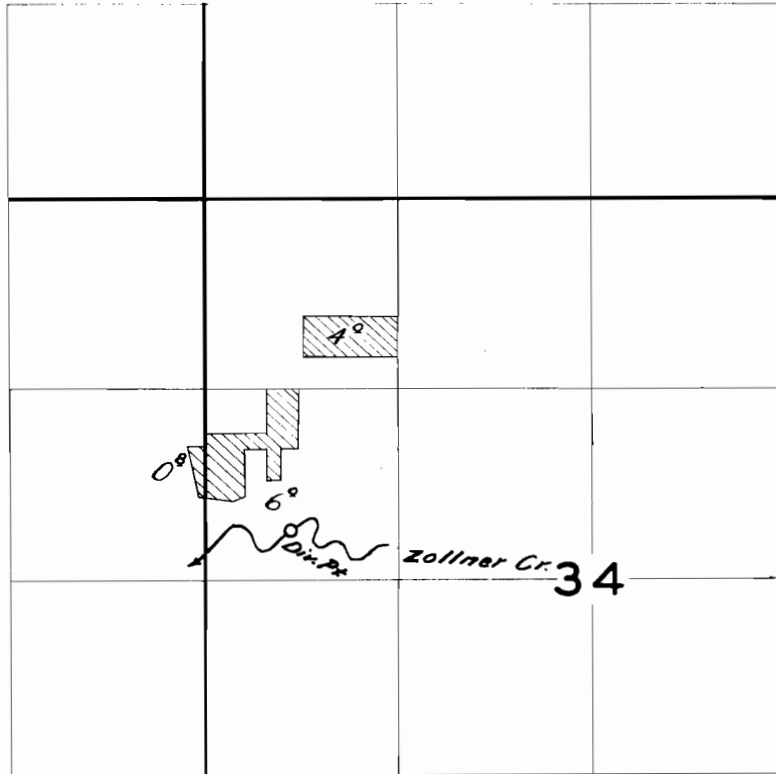

**FINAL PROOF SURVEY**

UNDER

Application No. *26717*... Permit No. *21020*...

IN NAME OF

..... *R. T. Fessler* .....

Surveyed *June 1*, 1956, by *C. O. Bartels*