


T.28 S. R. 7 W. W.M.

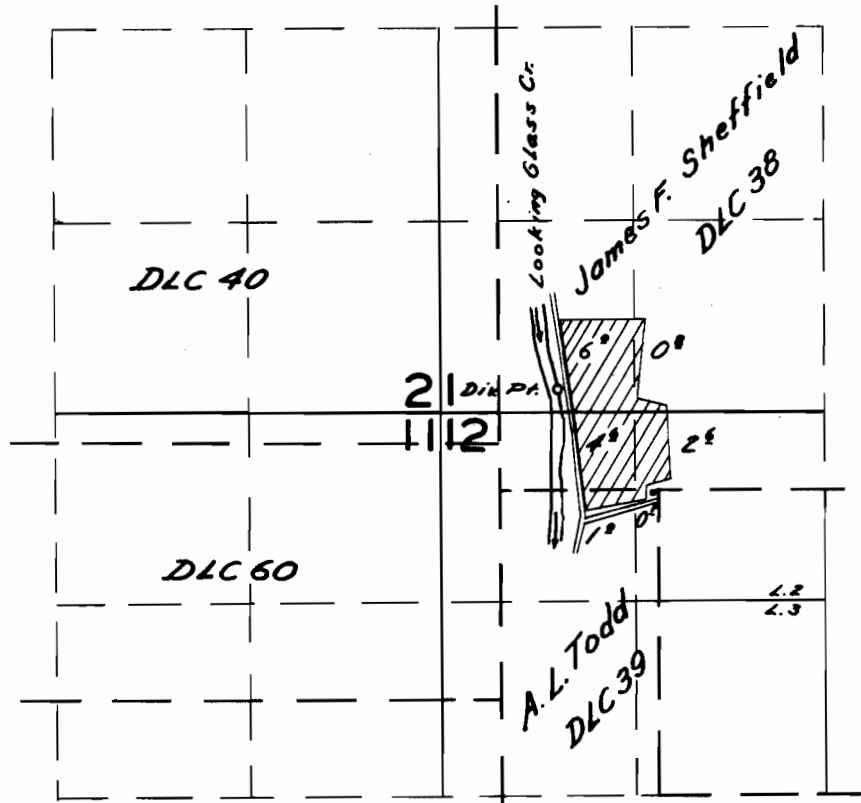

FINAL PROOF SURVEY

UNDER

Application No. 26257 Permit No. 21028
IN NAME OF

W. H. Niebaum

Surveyed Aug. 9 1956, by C. O. Bartels