


T. 5 S. R. 3 W. W.M.

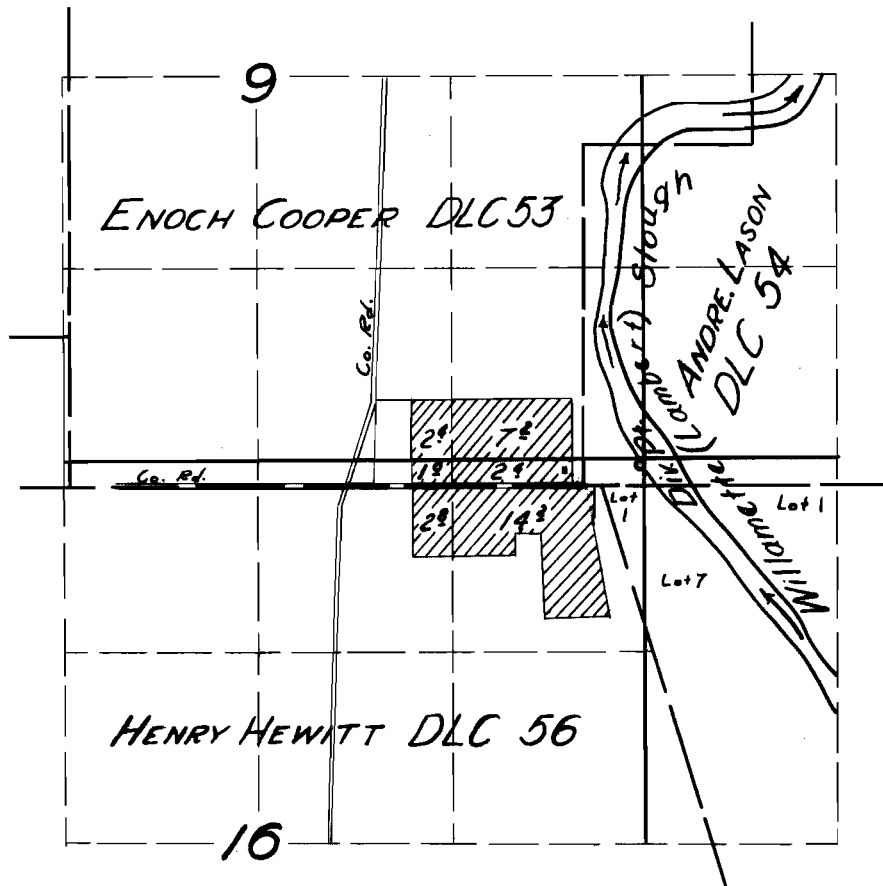

FINAL PROOF SURVEY

UNDER

Application No. 26839 Permit No. 21079

IN NAME OF

VICTOR E. & SYLVIA GEIGER

Surveyed 20 Mar. 1956, by C. A. Whitby