


T. 3 & 4 S. R. 4 W. W.M.

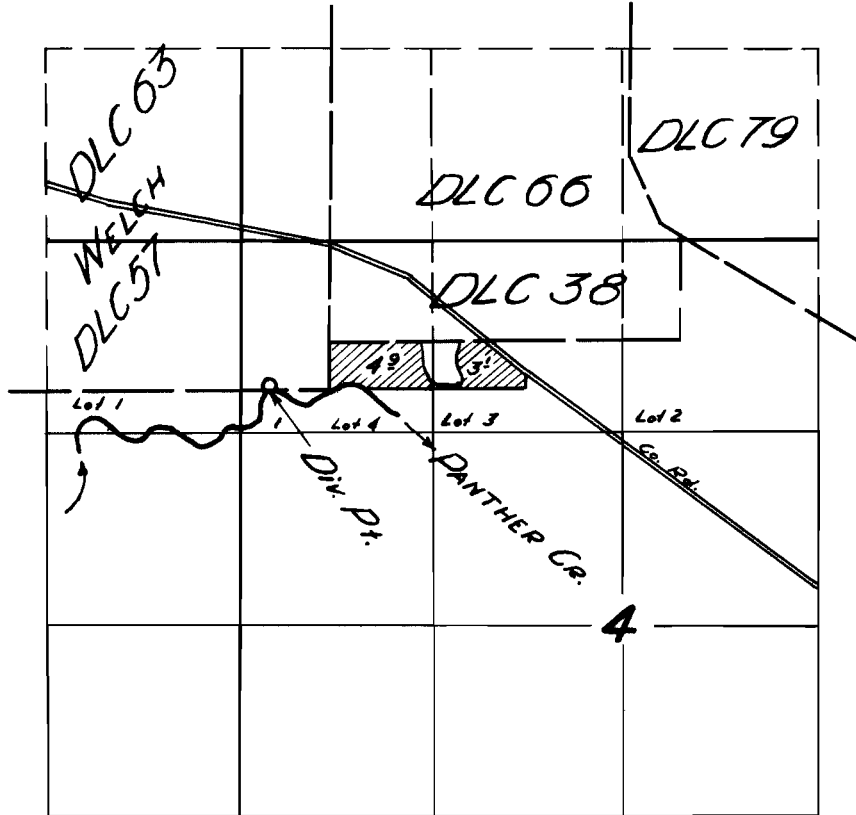

**FINAL PROOF SURVEY**

UNDER

Application No. 20849 Permit No. 21085

IN NAME OF

JOHN A. SITTON

Surveyed 2 Apr. 1956, by [Signature]