


T. 6 S. R. 1 W. W. M.

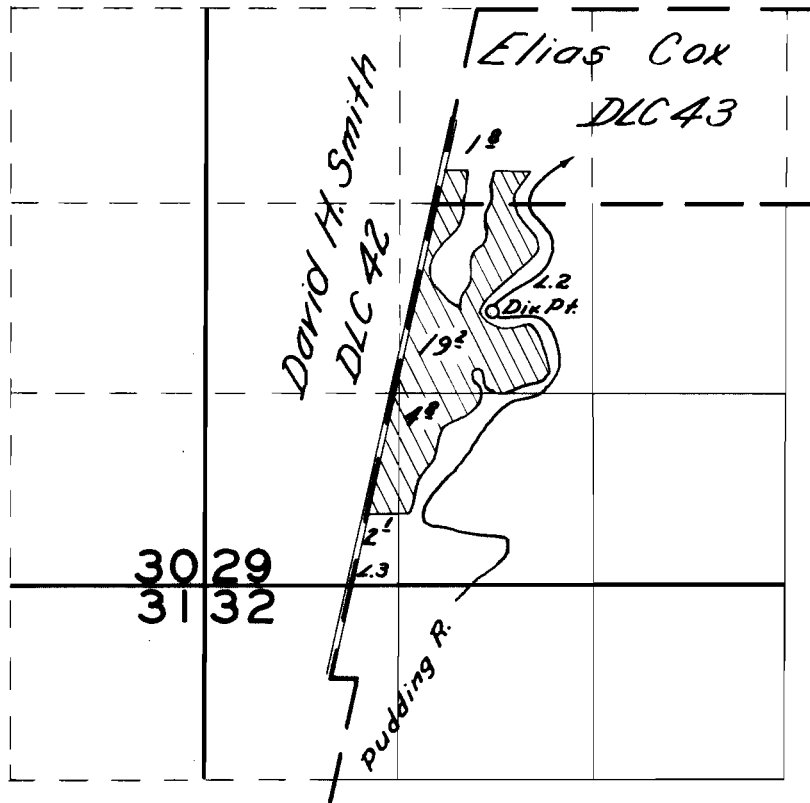

**FINAL PROOF SURVEY**

UNDER

Application No. *26870*. Permit No. *21099*...

IN NAME OF

.....*Alfred & Alma C. Menter*.....

Surveyed *May 24 1956*, by *C.O. Bartels*.