


T. 4S. R. 3E. W.M.

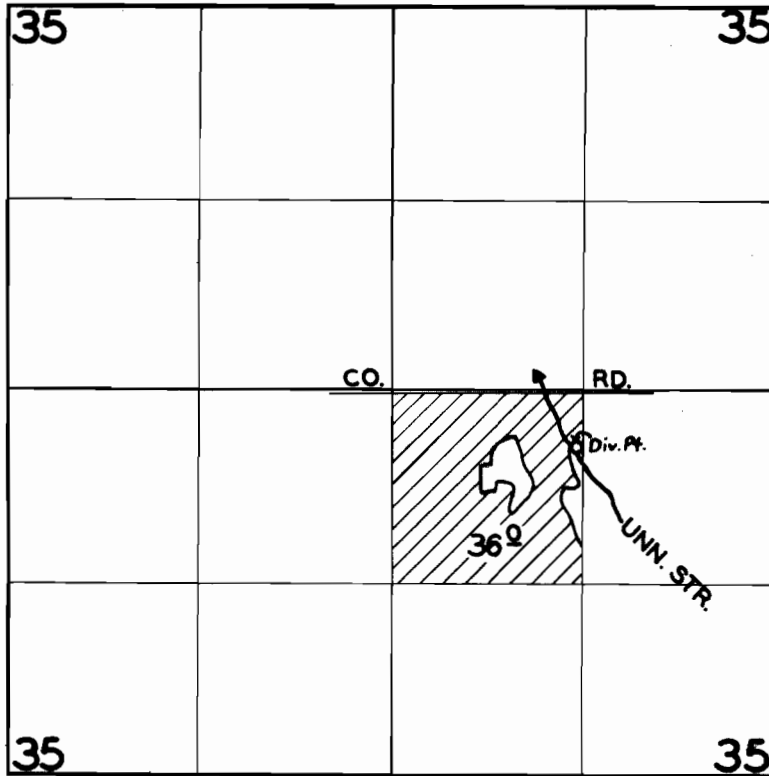

FINAL PROOF SURVEY

UNDER

Application No. 26919 Permit No. 21152

IN NAME OF

VINCENT H. BURDKICK

Surveyed 2 APR. 1956, by R.D. BEST