


T 10 S. R. 2 W. W. M.

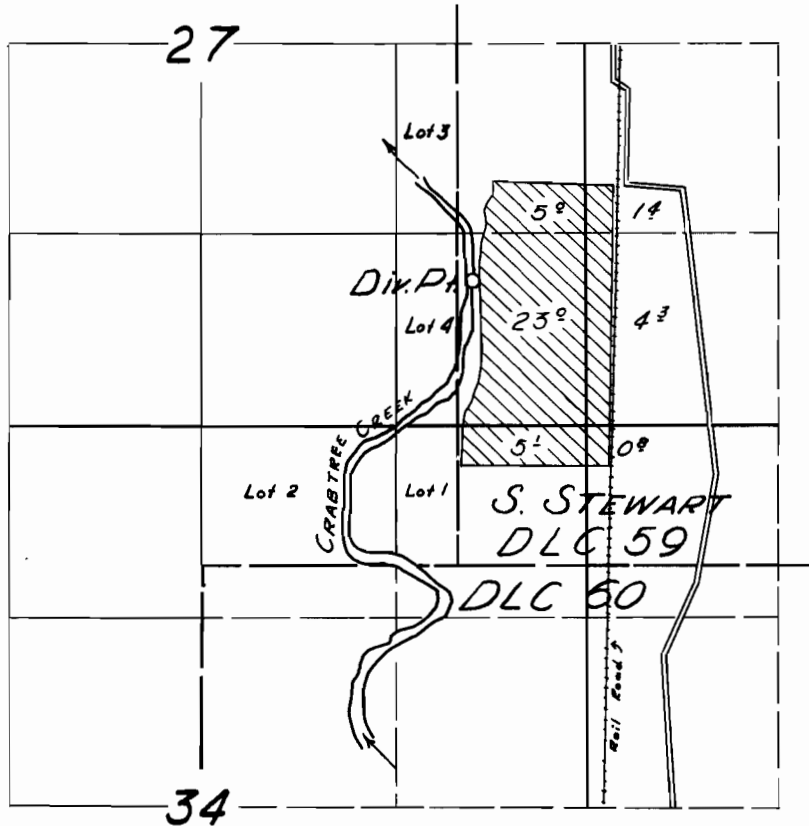

FINAL PROOF SURVEY
UNDER

Application No. 26934 Permit No. 21162

IN NAME OF

C. C. & EVA E. MESPELT

Surveyed 27 July 1956, by *[Signature]*