T. 3 & 4 S. R. 4 W. W.M.

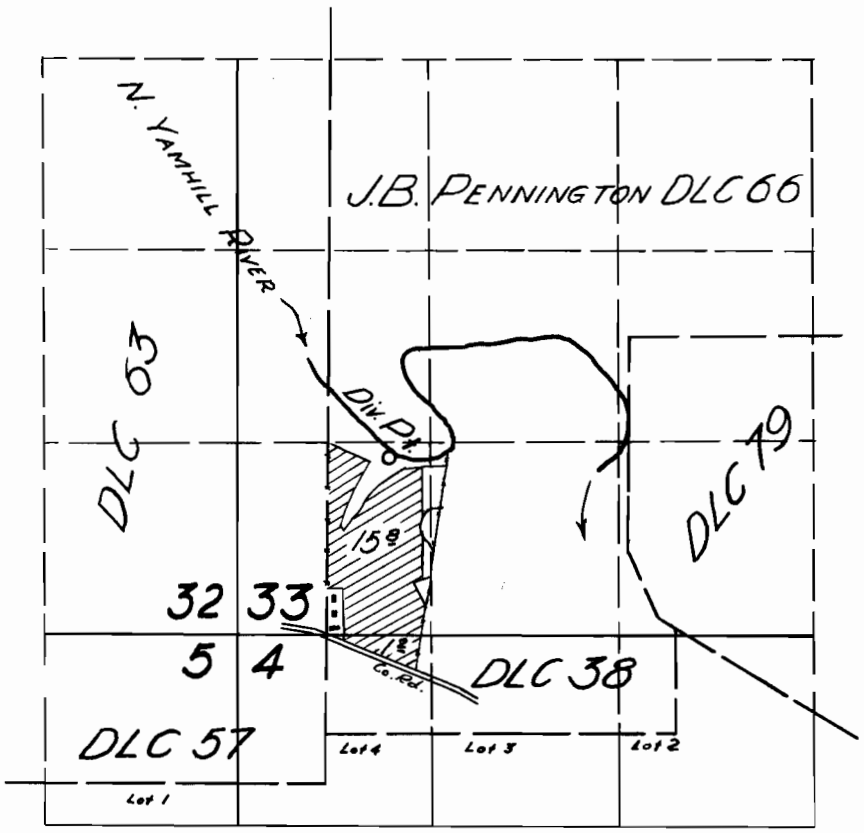

FINAL PROOF SURVEY

UNDER

Application No. 27015 Permit No. 21217

IN NAME OF

CHARLES E. SITTON

Surveyed 2 Apr. 1956, by C. Whitby

DFQ-5D-59