T1S, R3 & 4W, WM

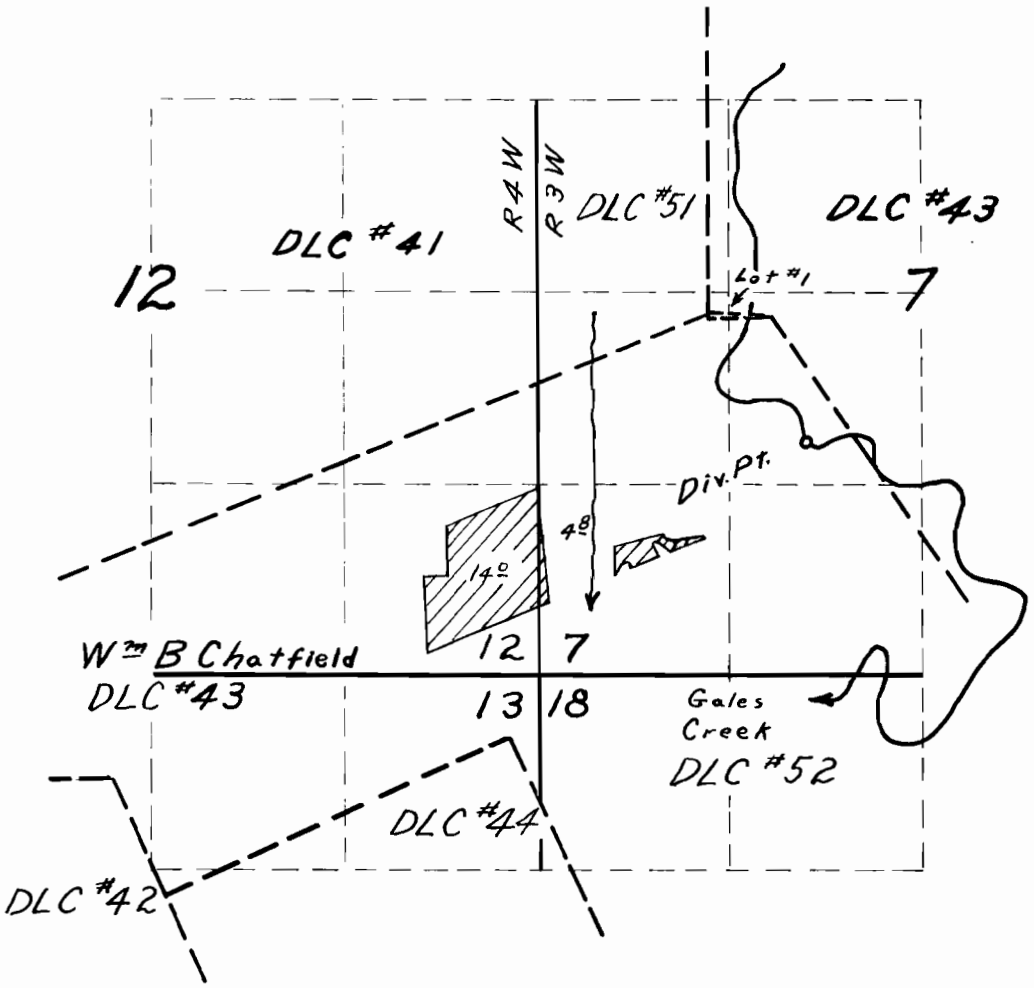

FINAL PROOF SURVEY

UNDER

Application No. 27062 Permit No. 21293

IN NAME OF

Martin E. Gerdes

Surveyed 5-1 1956, by R.D. Best

DFR-3D-182 WC