


T 4S. R. 1E. W.M.

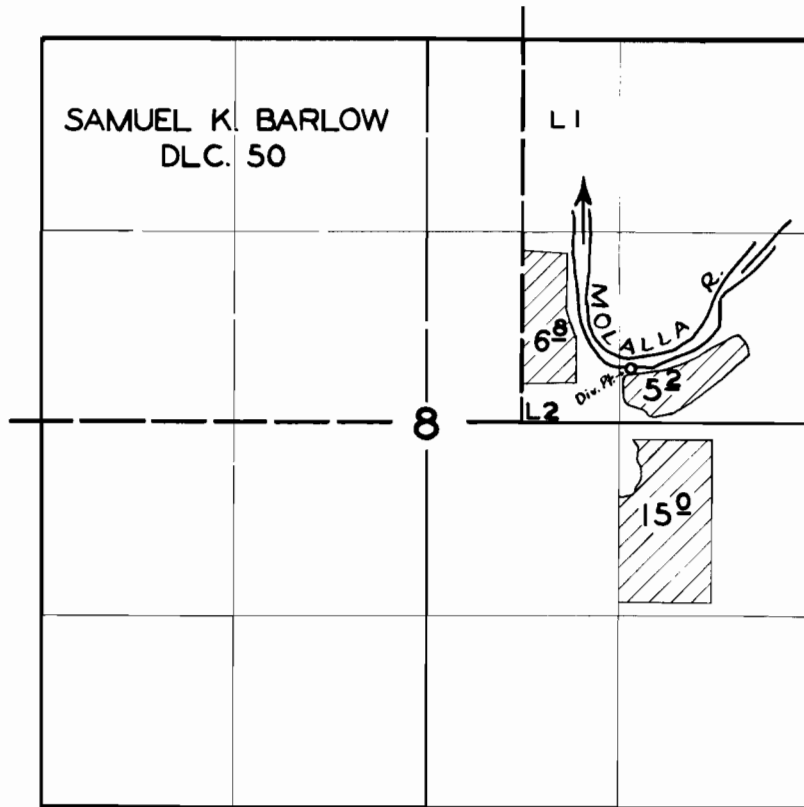

FINAL PROOF SURVEY

UNDER

Application No. 27191 Permit No. 21303

IN NAME OF

CLAUDE A. PULLEN

Surveyed 8 MAR. 1956, by R. D. BEST

DFK - 3D - 51

RWB