


T.3S.R.5W.W.M.

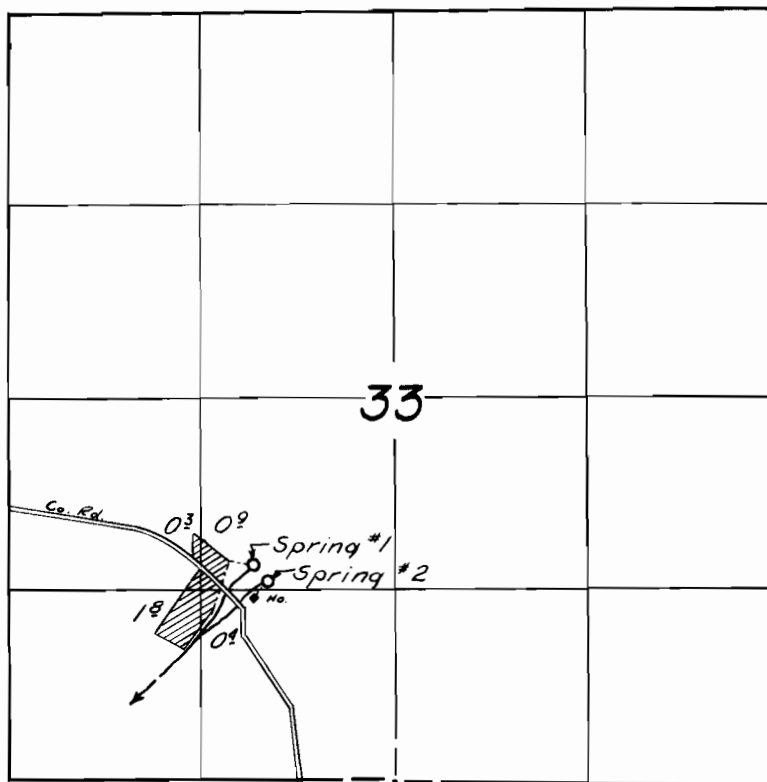

FINAL PROOF SURVEY
UNDER

Application No. 27209 Permit No. 21417

IN NAME OF

GEORGE J. & ANNA M. WIESSEMAN

Surveyed 4 Apr. 1956, by C. Markley