


T.26S. R.6W.W.M.

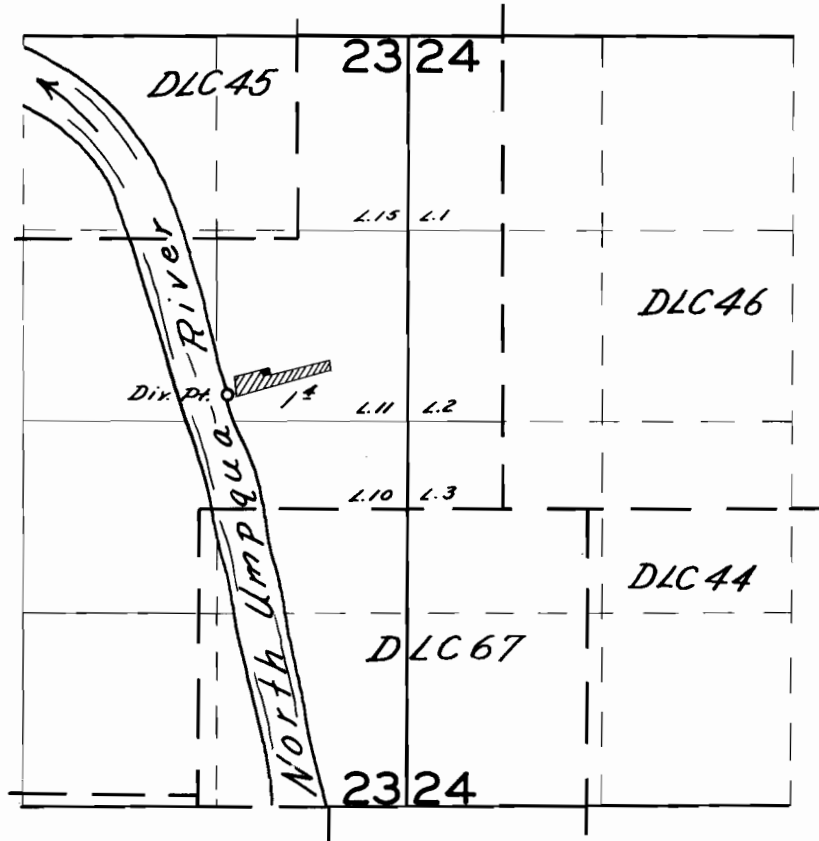

FINAL PROOF SURVEY

UNDER:

Application No. 27229. Permit No. 21423.

IN NAME OF

..... Roy K. Byrd

Surveyed June 5, 1956, by G. O. Bartels