


T. 4 & 5 S. R. 4 W. W. M.

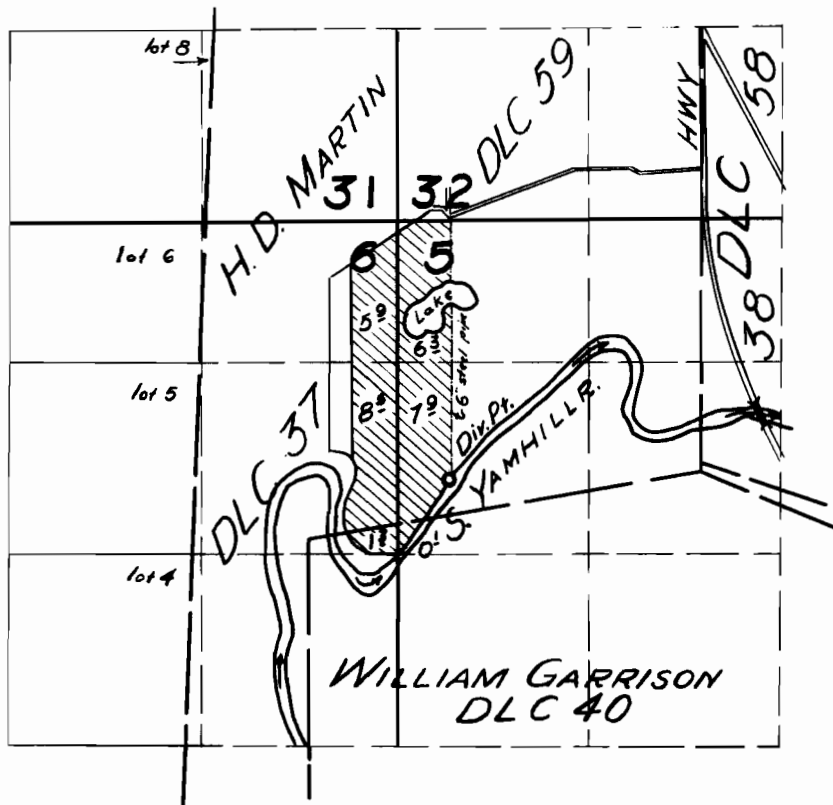

FINAL PROOF SURVEY
UNDER

Application No. 27423 Permit No. 21592
IN NAME OF

BYRON A. & MARIE WHITE

Surveyed 20 Mar 1956, by *[Signature]*