


T. 6 N. R. 10 W. W. M.

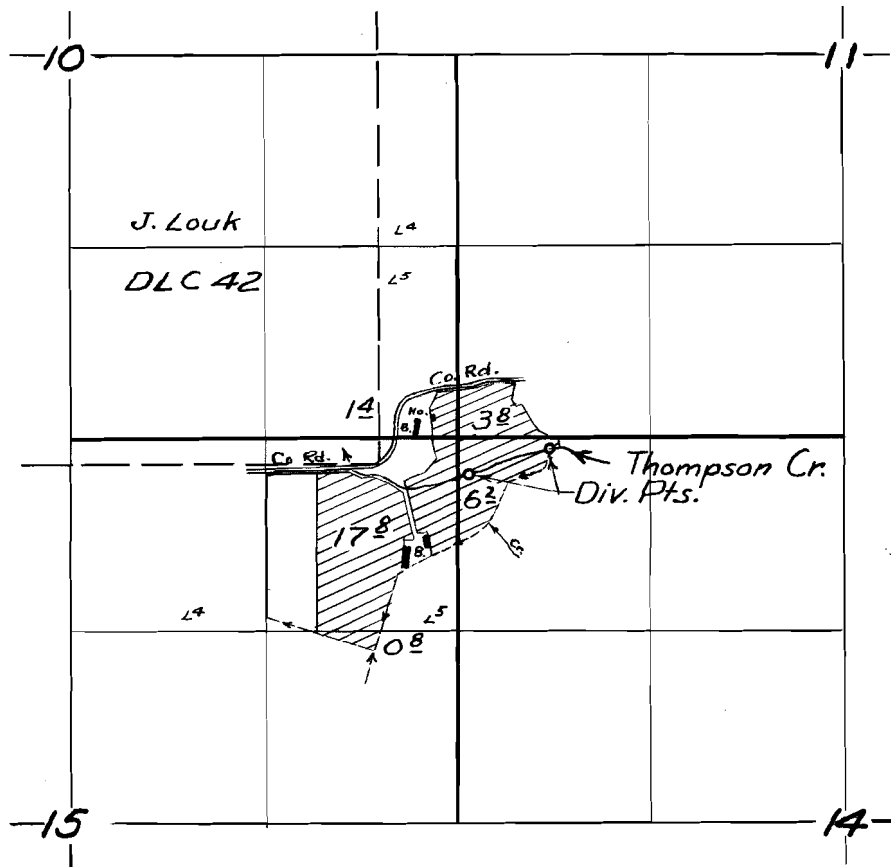

FINAL PROOF SURVEY
UNDER

Application No. 27496 Permit No. 21642
IN NAME OF

A. Morrison Work

Surveyed 20 Aug. 1956, by Tr. Bish