


T.4S.R.5W.W.M.

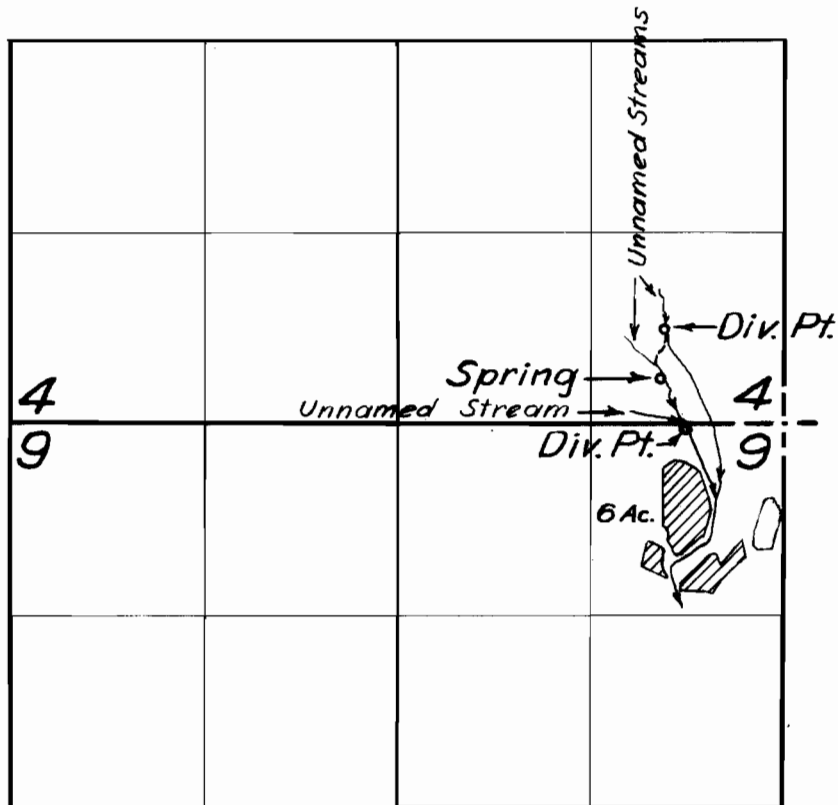

FINAL PROOF SURVEY

UNDER

Application No. 27673 Permit No. 21790

IN NAME OF

D. H. Lewis

Surveyed Mar. 12 1956, by M. Bish