


T2S, R2W, W.M.

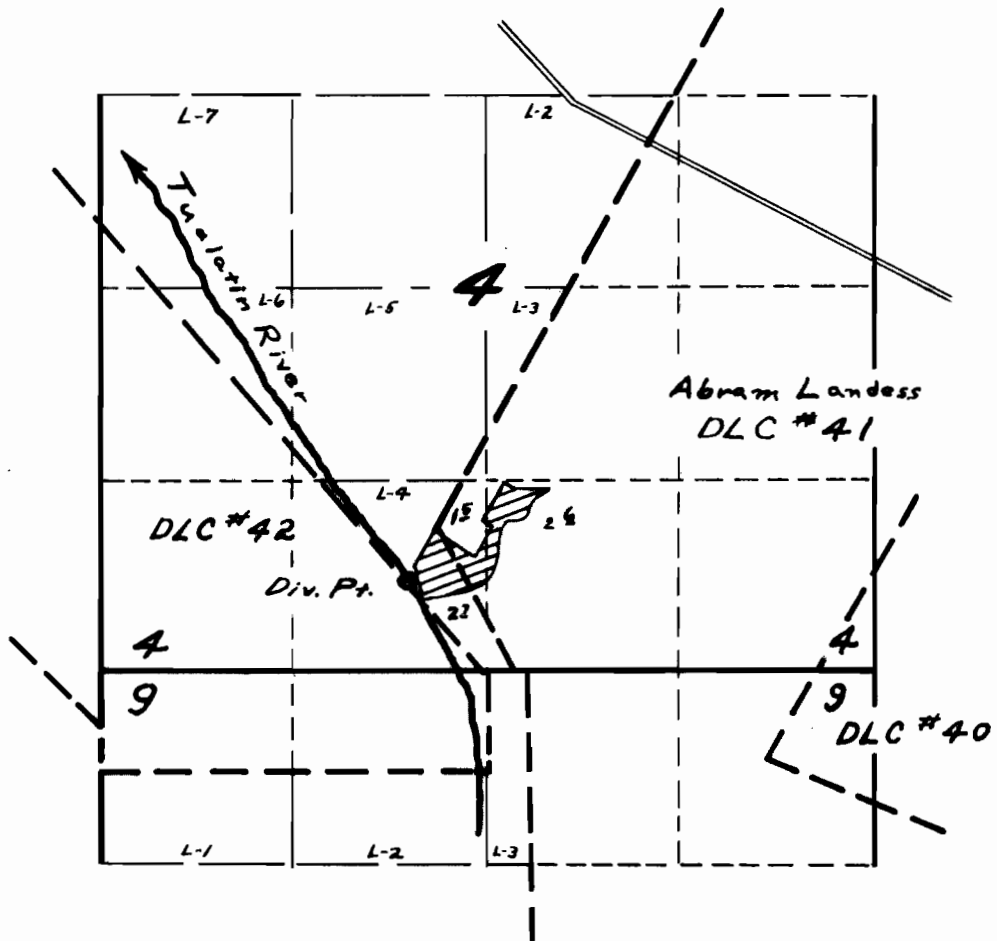

FINAL PROOF SURVEY
UNDER

Application No. 26880 Permit No. 21926
IN NAME OF

W.H. Decker

Surveyed 4-26 1956, by Myron Bish