


T.28S. R.6W.W.M.

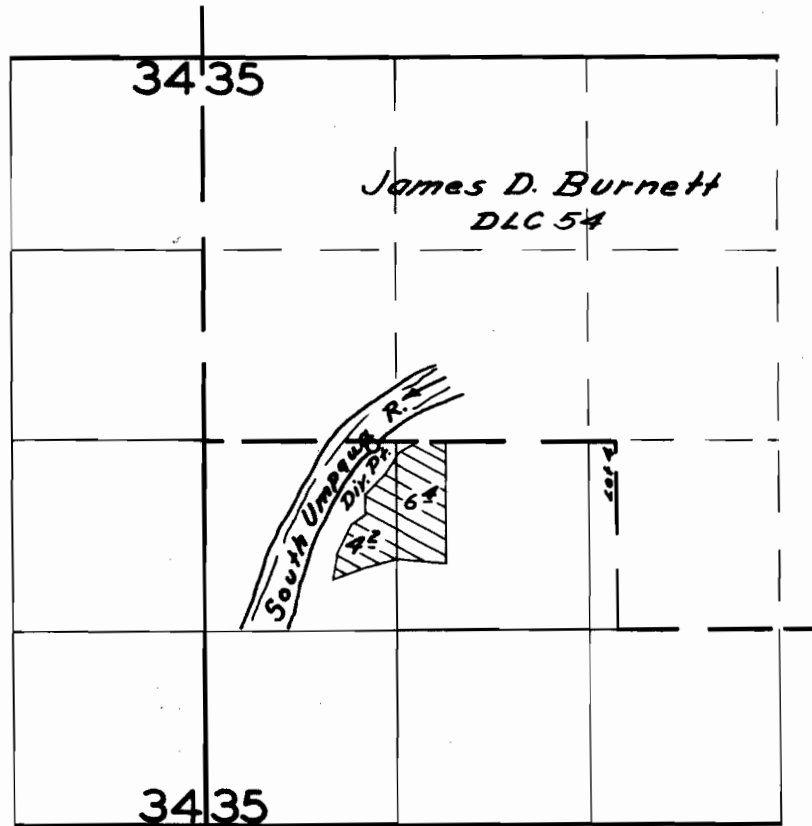

**FINAL PROOF SURVEY**

UNDER

Application No. 27967. Permit No. 22011...

IN NAME OF

..... *Abner J. Rice* .....

Surveyed *Aug. 5* 1956, by *C. O. Bantle*