


T. 6 S. R. 1 W. W. M.

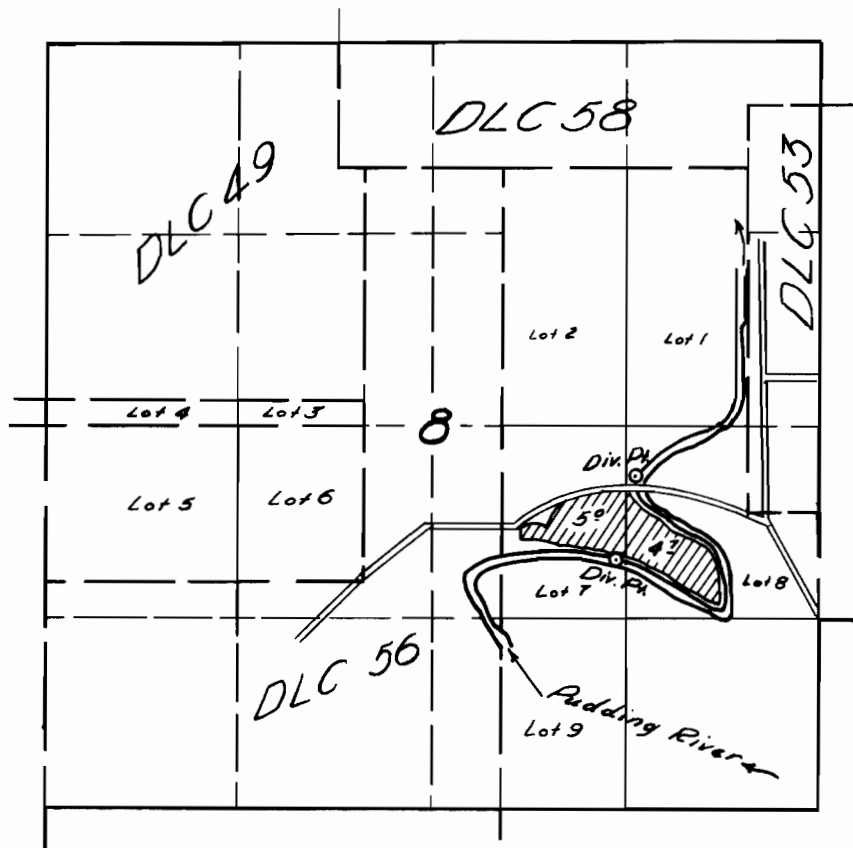

FINAL PROOF SURVEY

UNDER

Application No. 28065 Permit No. 22075

IN NAME OF

MR. & MRS. HENRY H. JOHNSON

Surveyed 30 Mar 1956, by *[Signature]*