


T. 5 E 6 S. R. 5 W. W.M.

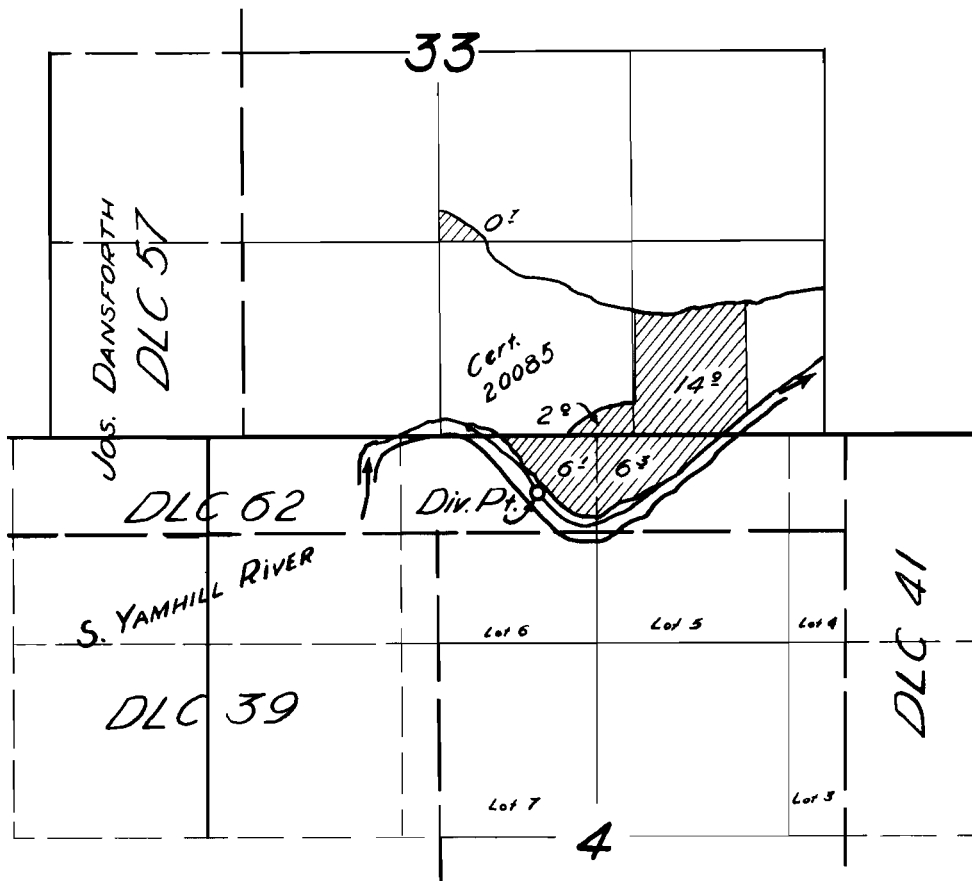

FINAL PROOF SURVEY
UNDER

Application No. 28071 Permit No. 22081
IN NAME OF

JOHN DEJONG

Surveyed 28 Mar. 1956, by