


T. 5S. R. 2E. W.M.

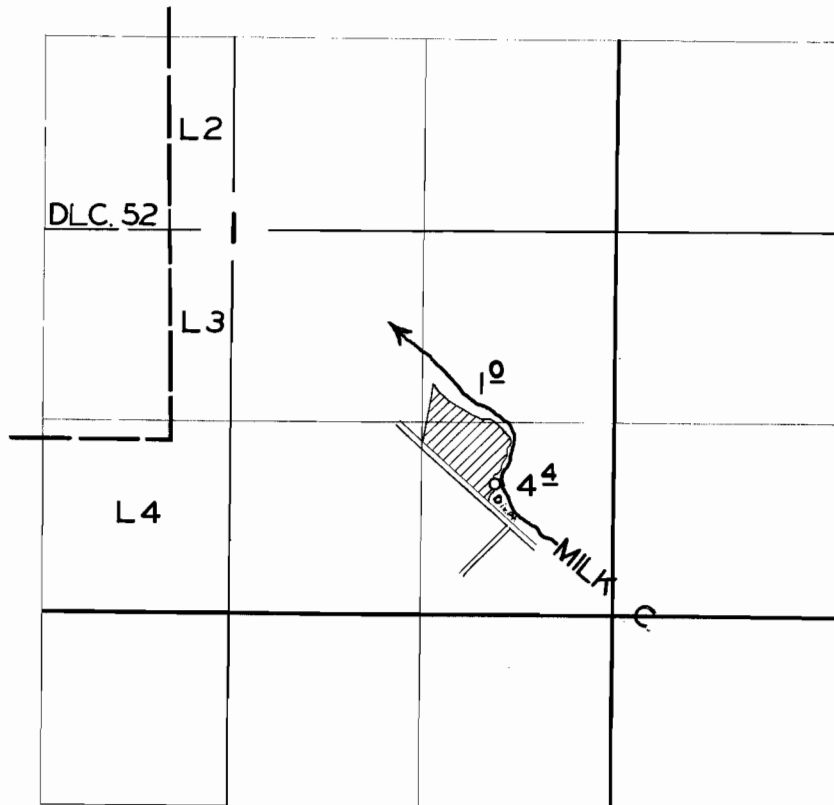

FINAL PROOF SURVEY
UNDER

Application No. 28281 Permit No. 22237
IN NAME OF

ARTHUR O. & HATTIE F. OREM

Surveyed 15 MAR. 1956, by R.D. BEST