


T.25 S, R.6 W.W.M.

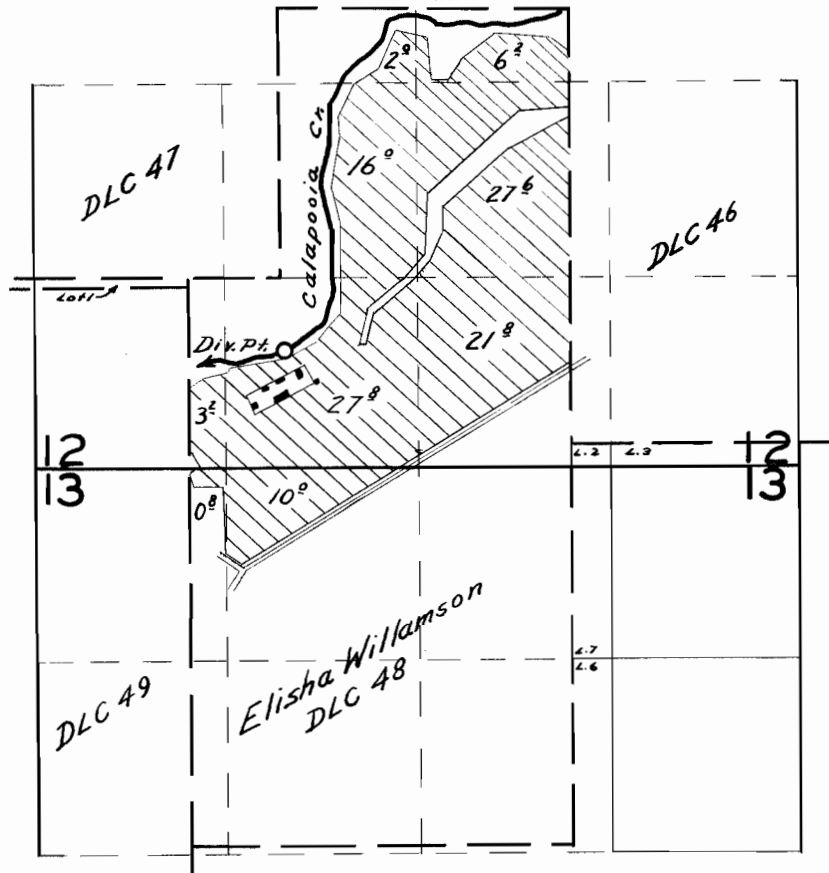

**FINAL PROOF SURVEY**

UNDER

Application No. 28444.. Permit No. 22283..

IN NAME OF

*Harry Baimbridge*

Surveyed *Aug. 21* 1956, by *C.O. Bartels*