


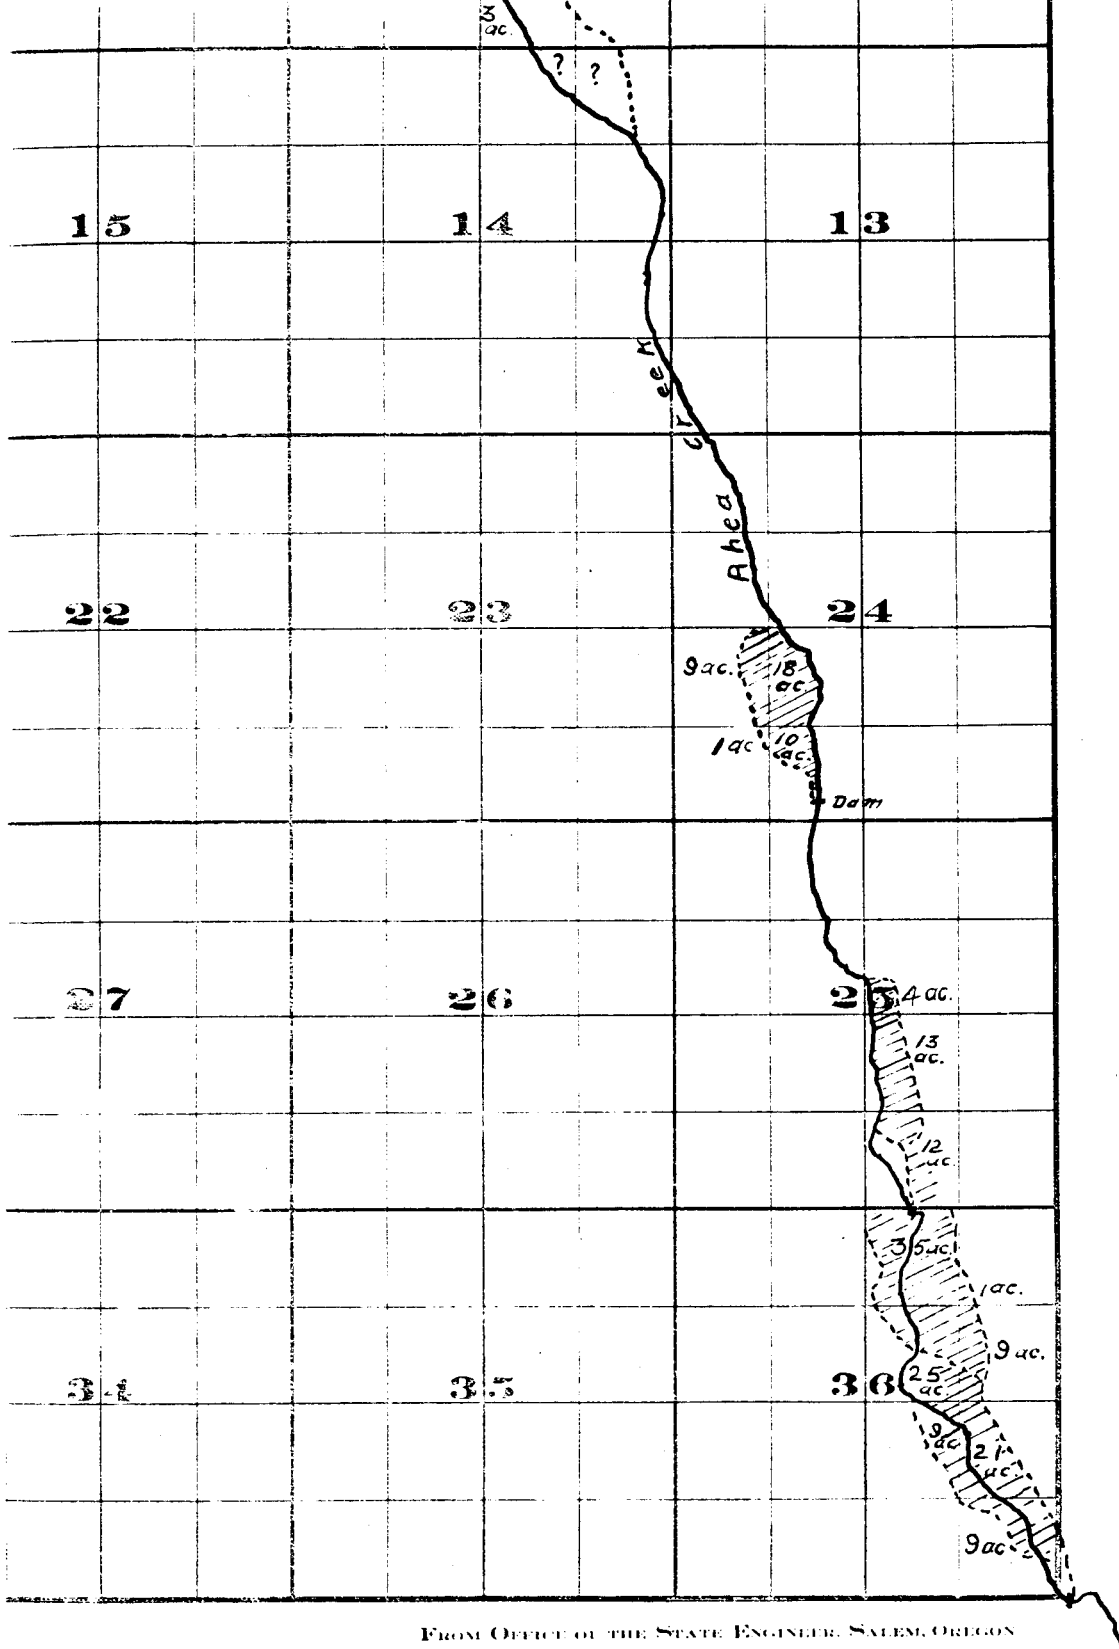

FROM OFFICE OF THE STATE ENGINEER, SALEM, OREGON

*Willow Creek Adjudication.*

*2 S. 24 E.*

|    |  |    |  |    |  |    |
|----|--|----|--|----|--|----|
| 7  |  | 8  |  | 9  |  | 10 |
|    |  |    |  |    |  |    |
|    |  |    |  |    |  |    |
|    |  |    |  |    |  |    |
| 18 |  | 17 |  | 16 |  | 15 |
|    |  |    |  |    |  |    |
|    |  |    |  |    |  |    |
|    |  |    |  |    |  |    |
| 19 |  | 20 |  | 21 |  | 22 |
|    |  |    |  |    |  |    |
|    |  |    |  |    |  |    |
|    |  |    |  |    |  |    |
| 30 |  | 29 |  | 28 |  | 27 |
|    |  |    |  |    |  |    |
|    |  |    |  |    |  |    |
|    |  |    |  |    |  |    |
| 31 |  | 32 |  | 33 |  | 34 |
|    |  |    |  |    |  |    |
|    |  |    |  |    |  |    |


*Surveyed by R.D. Cooper July 1909*

*John H. Lewis - State Engineer.*

*Examined July 14, 1909.*

Township 2 S.

[illegible]

