


T. 5 S. R. 1 W. W.M.

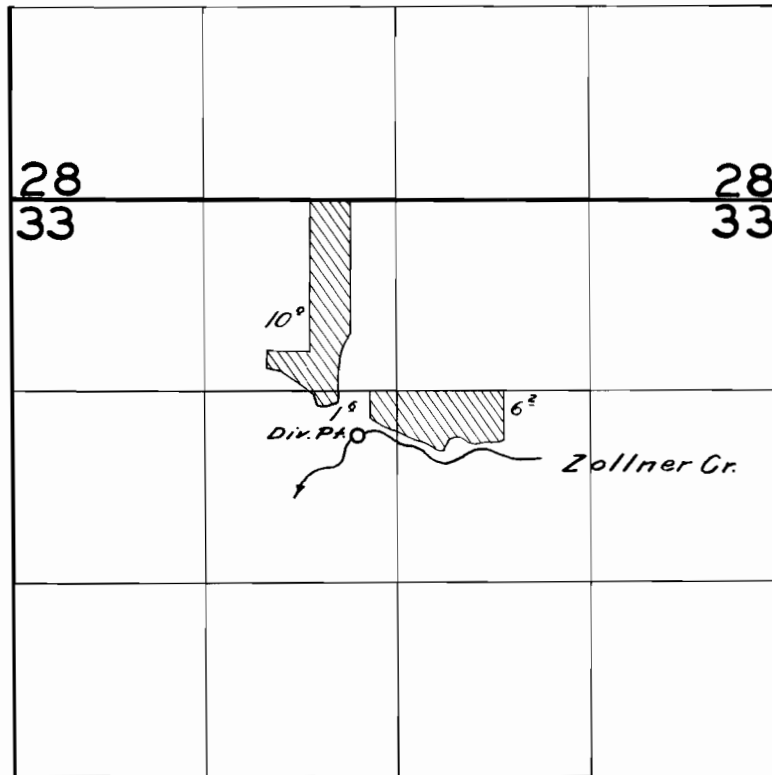

**FINAL PROOF SURVEY**

UNDER

Application No. *29014* Permit No. *23108*...

IN NAME OF

*R. T. Fessler*

Surveyed *June 1, 1956*, by *C. O. Bartels*...