


T. 6 N. R. 10 W. W. M.

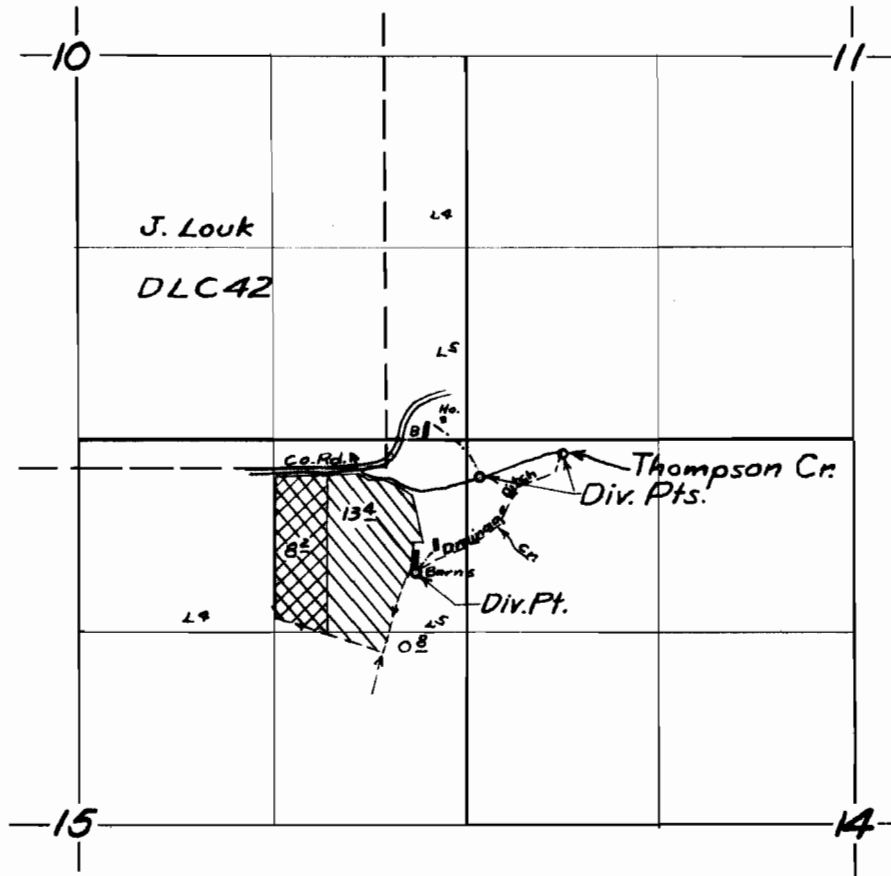

FINAL PROOF SURVEY
UNDER

Application No. 29305 Permit No. 23124
IN NAME OF

A. Morrison Work

Surveyed 20 Aug. 1956, by Tr. Bish
From Thompson Cr.
From Drainage

