


T. 3 S. R. 4 W. W. M.

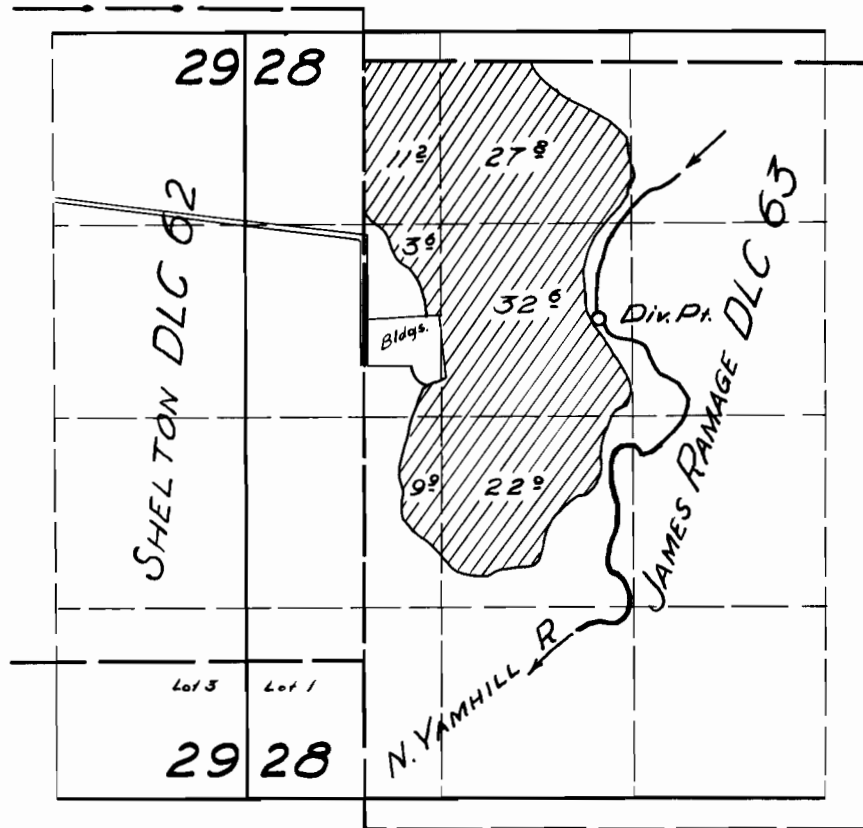

FINAL PROOF SURVEY
UNDER

Application No. 29738 Permit No. 23428
IN NAME OF

J. V. SPRINGER & J. JULIUS FRAHM

Surveyed 19 Apr. 1956, by [Signature]