


T.28S. R.6W.W.M.

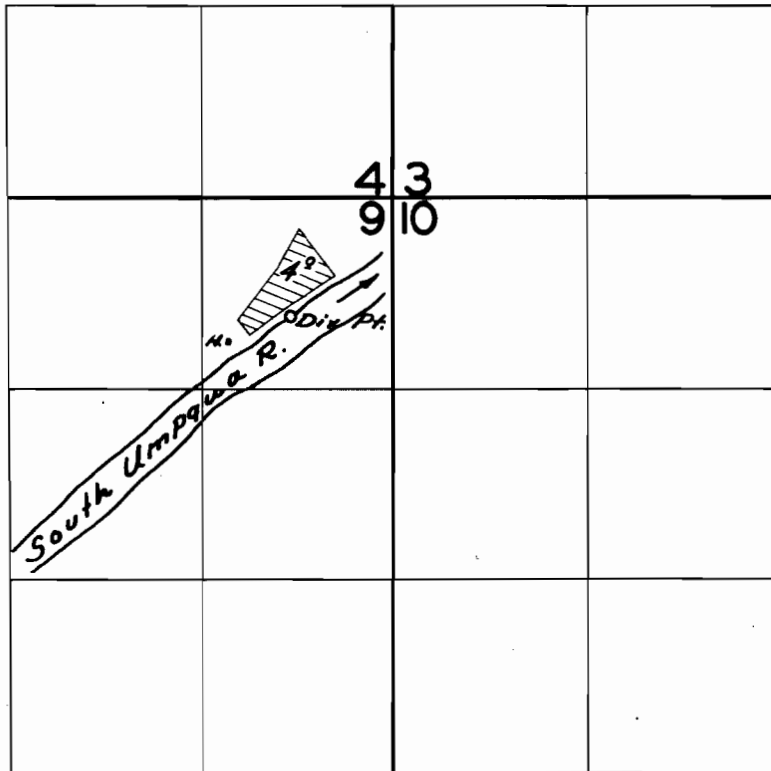

FINAL PROOF SURVEY

UNDER

Application No. *29689* Permit No. *23377*

IN NAME OF

Robert L. & Adaline L. Adams

Surveyed *June 15, 1956*, by *C. O. Bartels*