


T. 5 S. R. 7 W. W.M.

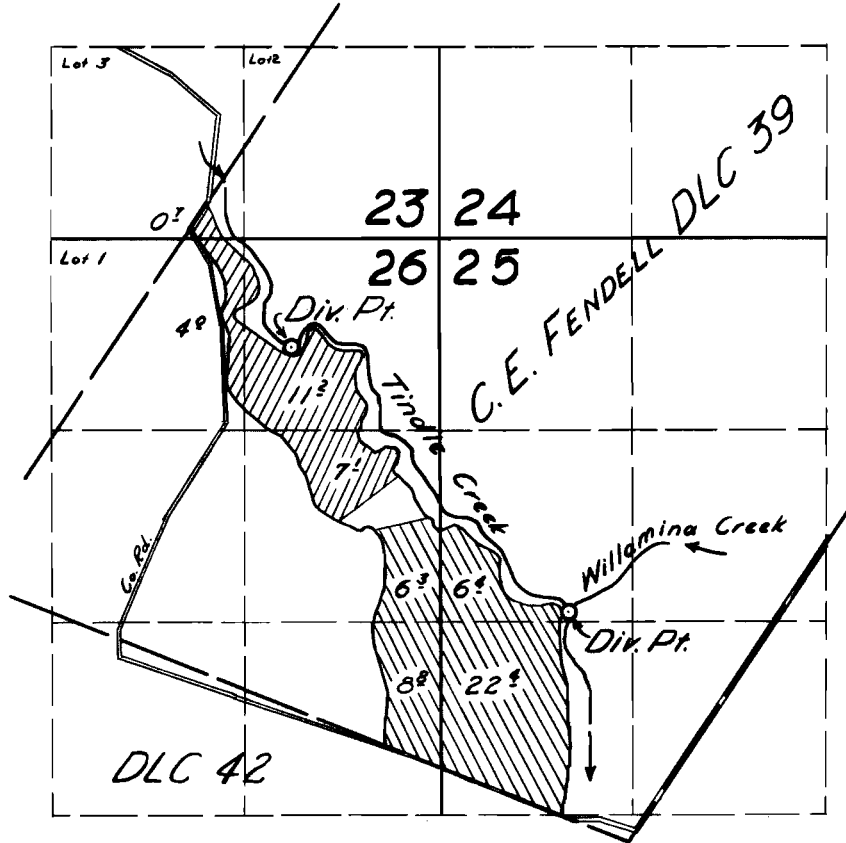

FINAL PROOF SURVEY

UNDER

27684

21796

Application No. 30332

Permit No. 23863



IN NAME OF

HARLEY MISHLER

Surveyed 26 Mar. 1950, by