


T. 6 S., R. 10 W. W.M.

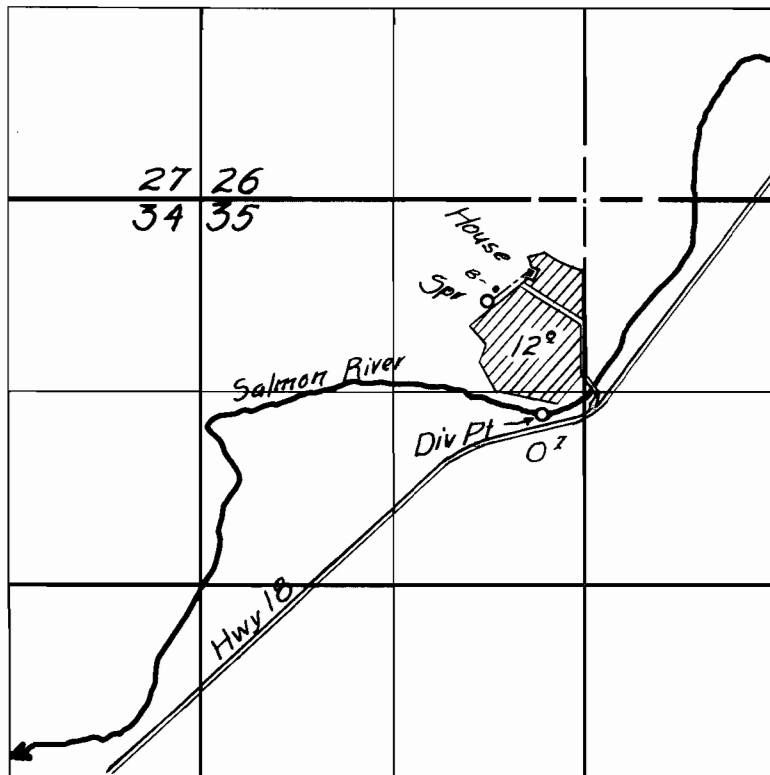

FINAL PROOF SURVEY
UNDER

Application No. *22533* Permit No. *17913*
IN NAME OF

RAY DRAYTON

Surveyed *24 August 1956*, by *Robert H. Reed*