


T. 4S. R. 2E. WM.

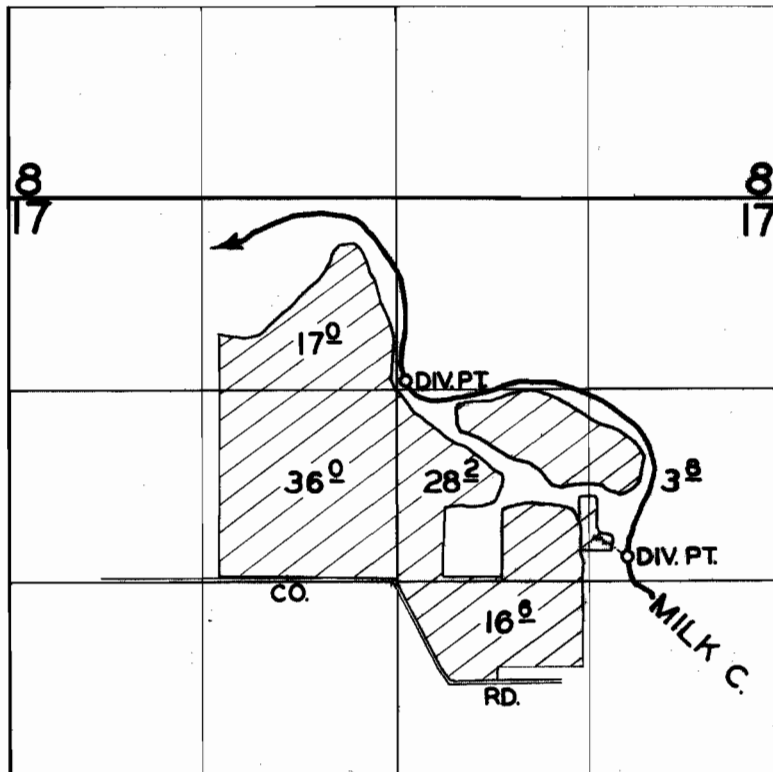

**FINAL PROOF SURVEY**

UNDER

Application No. 17275 Permit No. 12985

IN NAME OF

J. A. ELLISON

Surveyed 12 MAR. 1956, by R. D. BEST