


T. 4 N. R. 2 W. W. M.

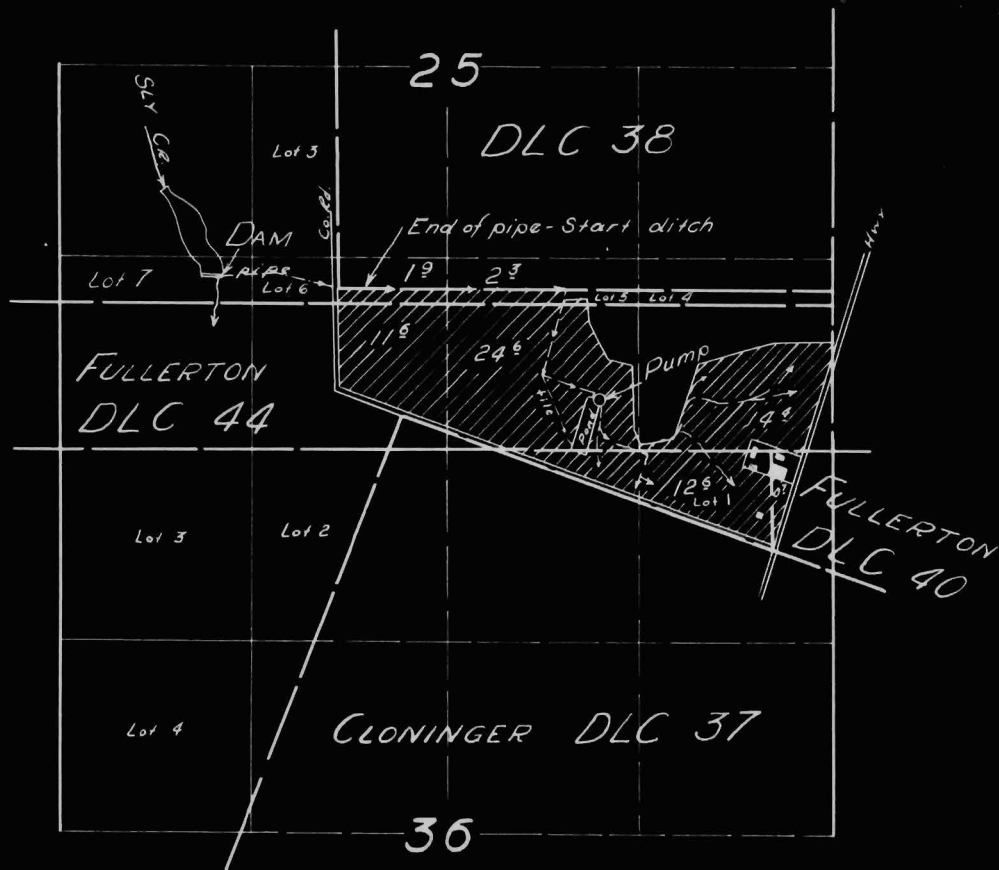

FINAL PROOF SURVEY

UNDER

R-19877

R-1049

Application No. 19878

Permit No. 19630

IN NAME OF

**JEWEL ICE CREAM CO.**

Surveyed 12 July 1956, by *E. W. Hutton*