


T. 4 S. R. 3 W. W.M.

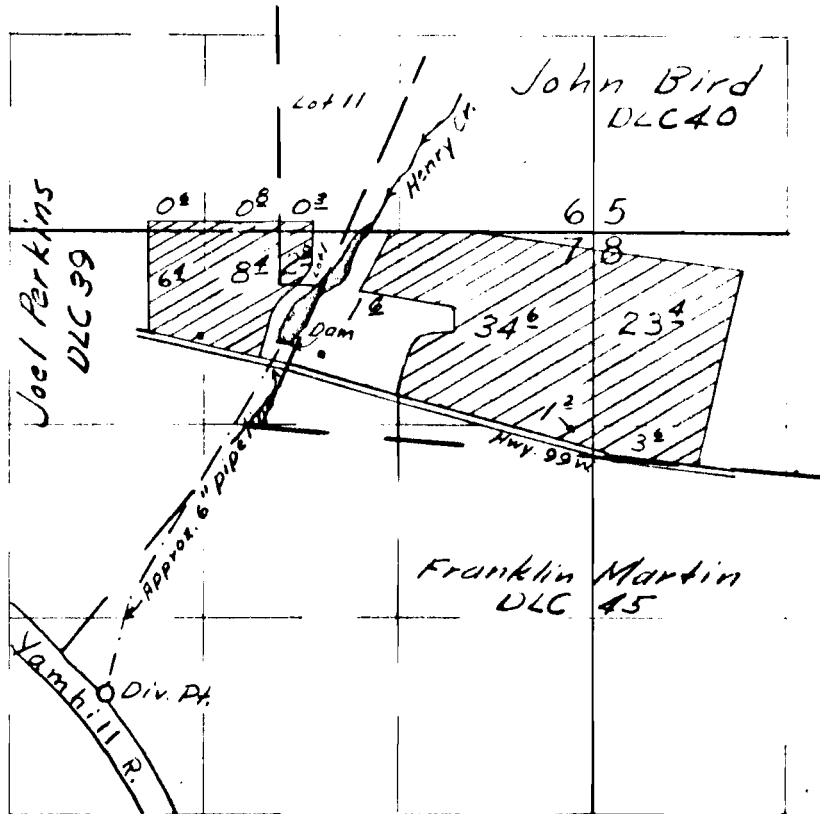

Final Proof Survey
Under
R-25394 R-1139
Application No. 25366 Permit No. 20213
In Name Of

Z. R. Schuetzel & Joseph Kudrna
Surveyed June 2 1955 by T. Jones