


T. 4 S. R. 3 W. W.M.

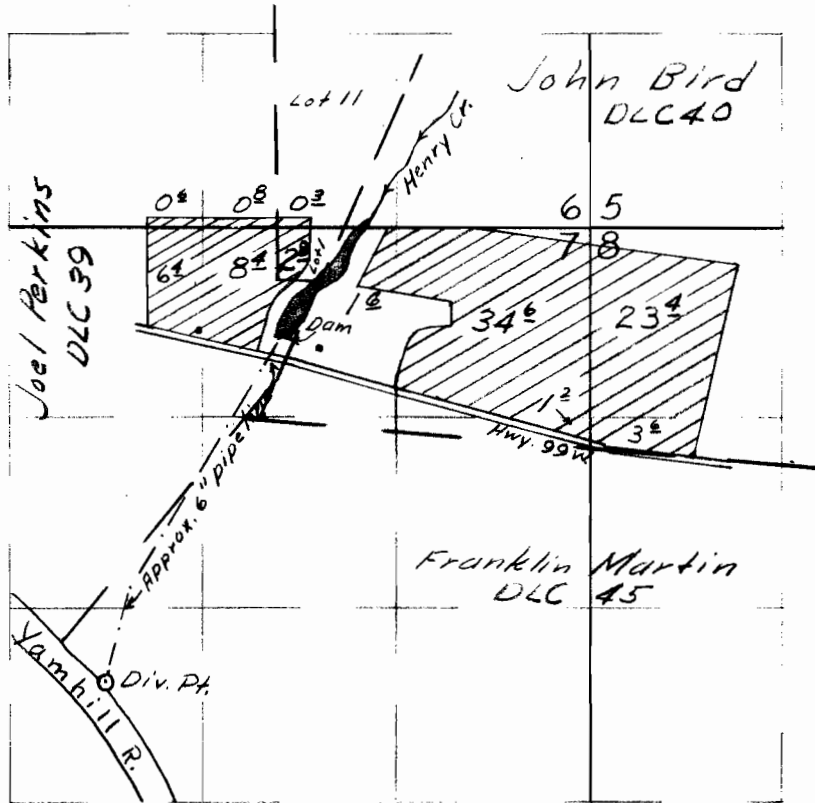

Final Proof Survey

Under

R-25394

R-1139

Application No. 25366 Permit No. 20213

In Name Of

Z. R. Schuetz & Joseph Kudrna

Surveyed June 2 1955 by T. Jones