


T. 4S. R. 2 & 3W. W.M.

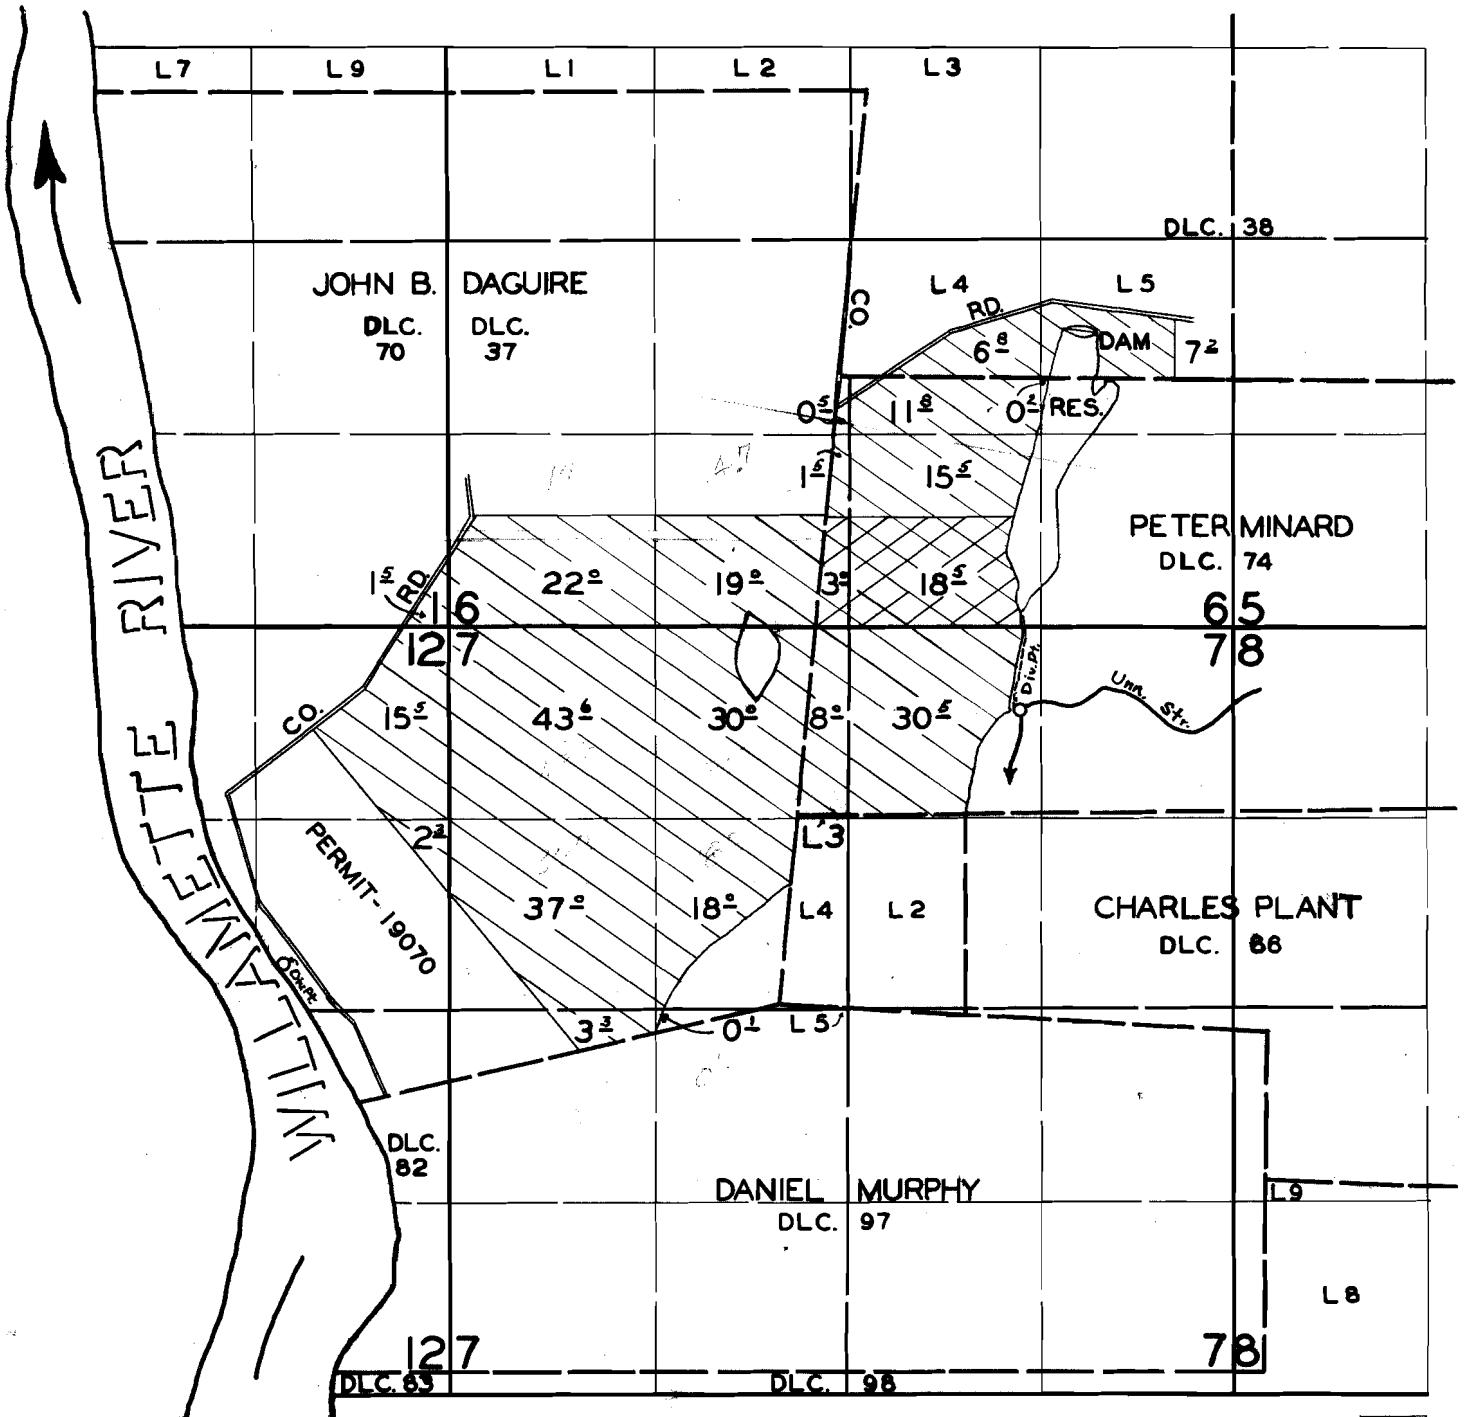

**FINAL PROOF SURVEY**

UNDER

R-25535

R-1145

Application No. 25536

Permit No. 20223

IN NAME OF

**JOHN L. & CATHERINE ANN MARXER**

Surveyed 2 MAR. 1956, by R.D. BEST

PRIM. -

SUPPL. -

*RDB*