


T. 7S. R. 1W.W.M.

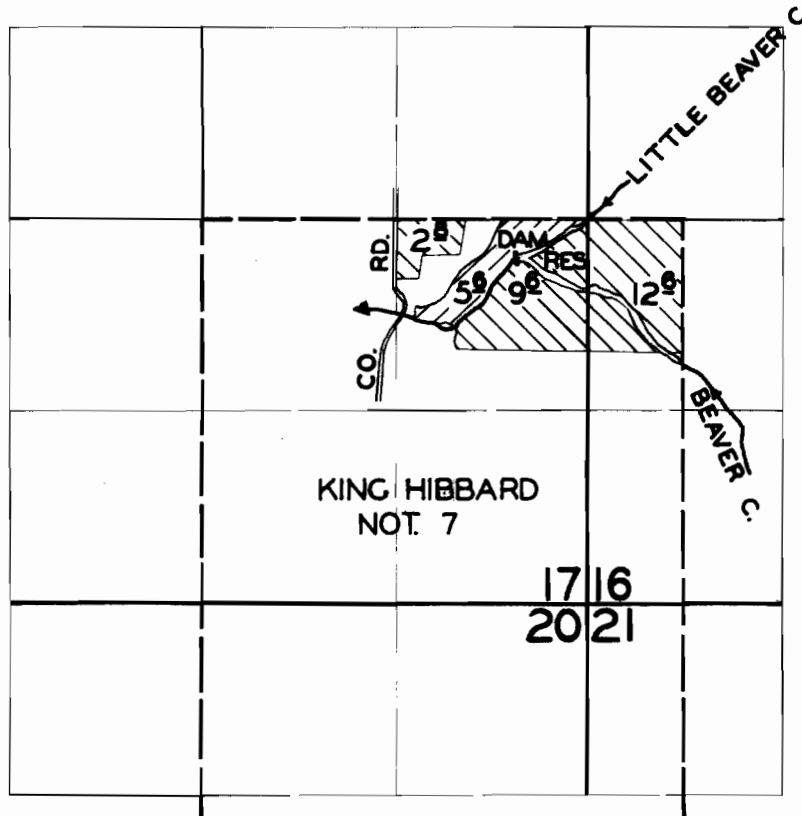

**FINAL PROOF SURVEY**

UNDER

R-25342

R-1136

Application No. 26213 Permit No. 20440

IN NAME OF

ERNEST KUENZI

Surveyed 5 MAR. 1956, by M. BISH

6/25