


T. 7S. R. 1W.W.M.

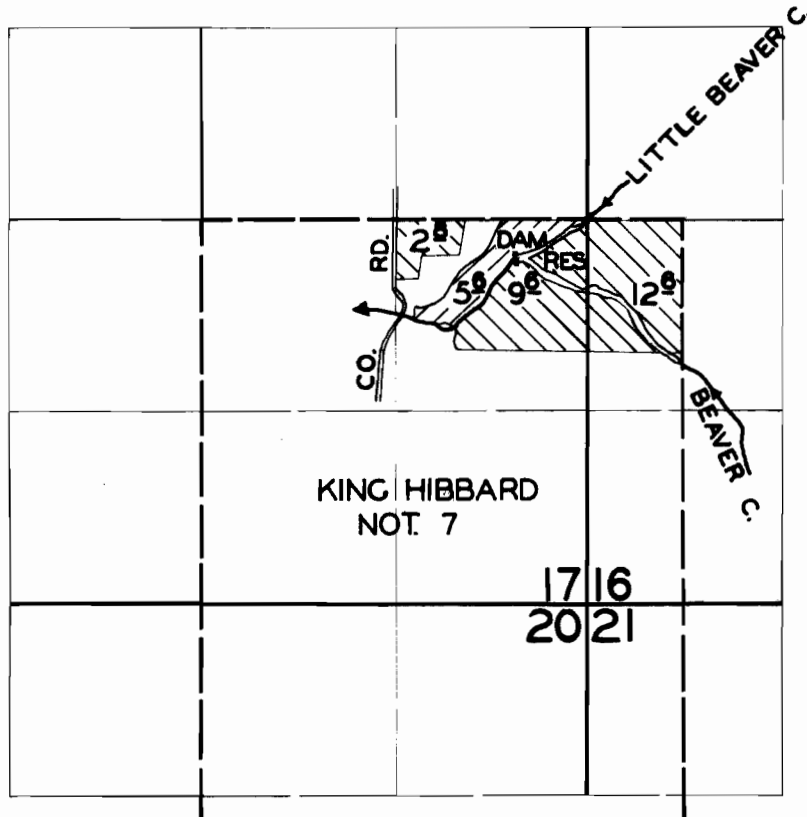

FINAL PROOF SURVEY

UNDER

R-25342

R-1136

Application No. **26213**

Permit No. **20440**

IN NAME OF

ERNEST KUENZI

Surveyed **5.MAR.** 1956., by **M.BISH**

kw