


T2S,R3W,W.M.

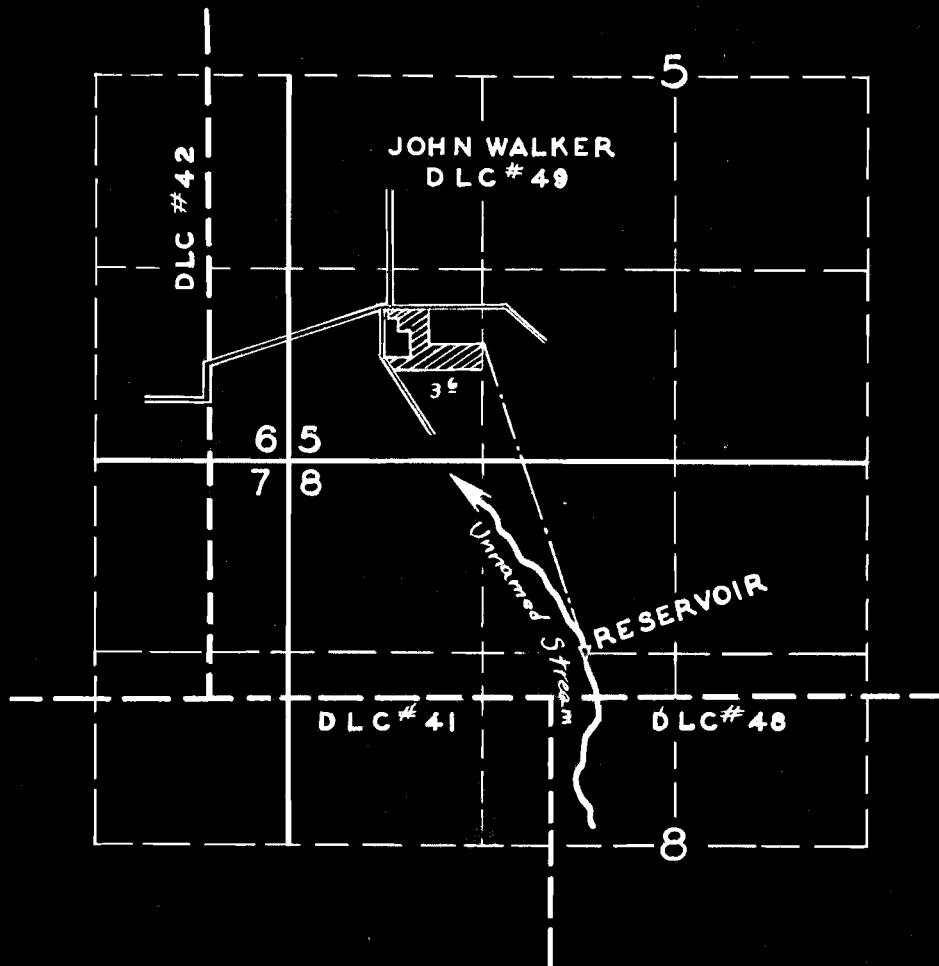

FINAL PROOF SURVEY

UNDER

R-25429

R-1199

Application No. 25071

Permit No. 20494

IN NAME OF

LEE HOFFMAN

Surveyed 4-26 1956, by R.D. BEST