


T2N, R4W, WM.

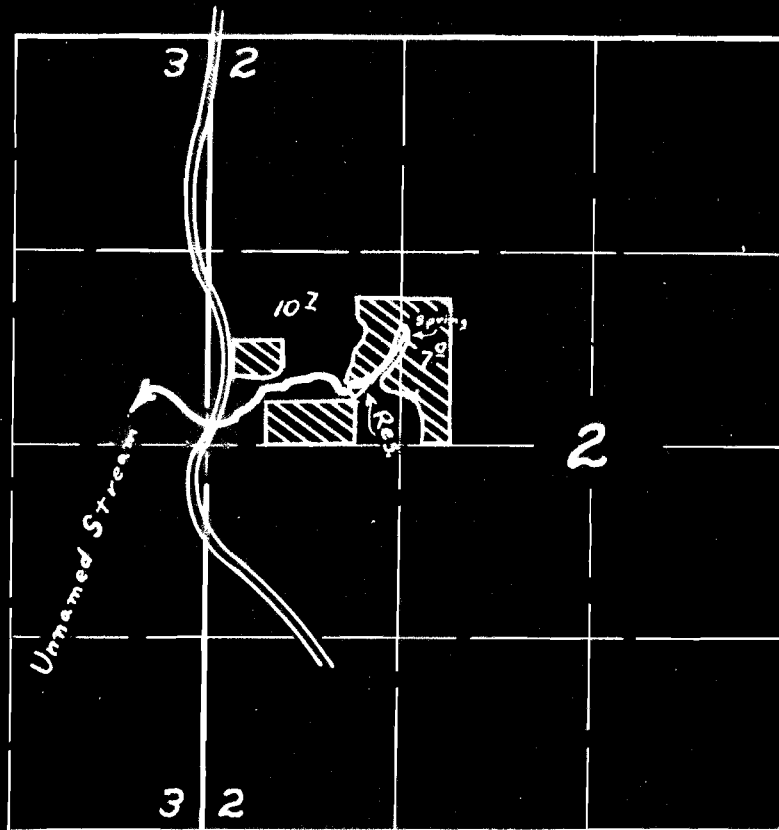

FINAL PROOF SURVEY

UNDER

R-25846

R-1210

Application No. 25846-7. Permit No. 20529

IN NAME OF

Wesley E. & Myrtle A. Duncan

Surveyed 4-17-1956, by R.D. Best