


T 3S. R. 4E. WM.

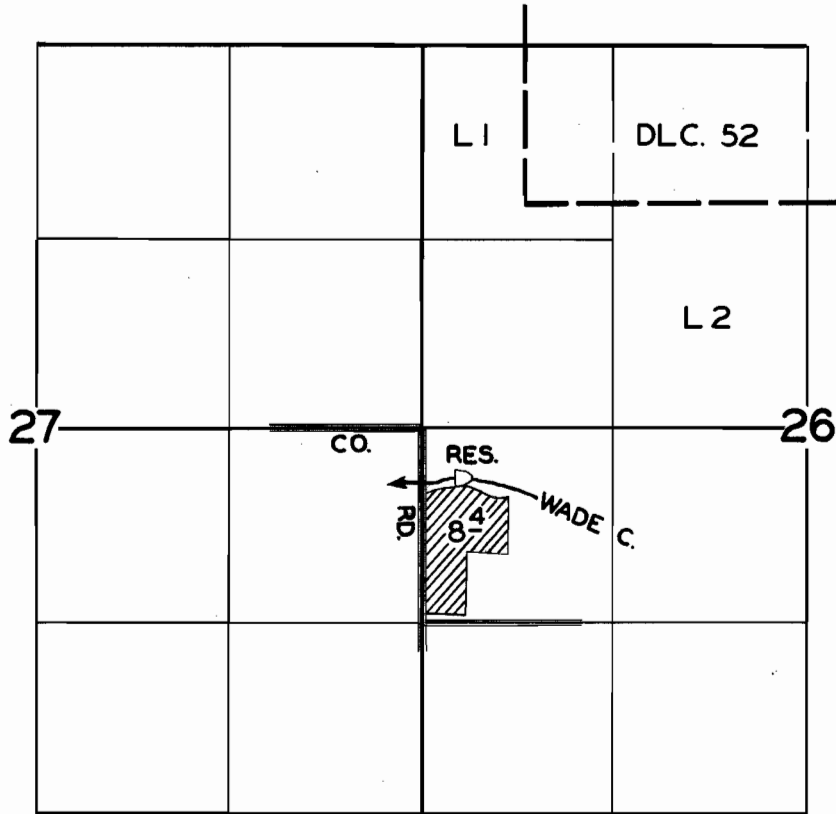

FINAL PROOF SURVEY

UNDER

R-26531

R-1268

Application No. 26532 Permit No. 20793

IN NAME OF

FRED D. RANDALL

Surveyed 4 APR. 1956, by R.D. BEST

DFK-4D-43

RWB