


T.3 S. R. 3E.W.M.

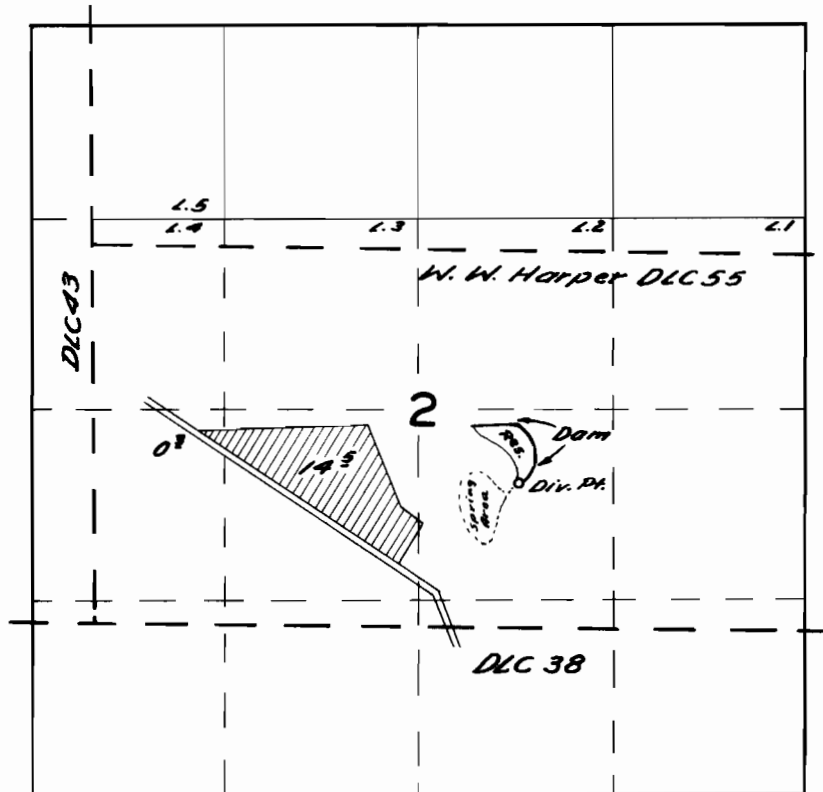

FINAL PROOF SURVEY

UNDER

Application No. *R-26986* *26987* Permit No. *R-1344* *21197*
IN NAME OF

H. W. McFadden

Surveyed *Sept. 26* 1956, by *C. O. Bartels*